

WASHINGTON

A 1018

7-18-78

MISSISSIPPI
BOARD OF WATER COMMISSIONERS
416 North State Street
Jackson, Mississippi 39201

WATER WELL DRILLERS LOG

18 July
date well completed

1928 Lambert Drilling Wash
firm name

Wash
county well located

LANDOWNER:	description of formations encountered	from	to
Bill Watts, Greenville, Miss. (mailing address)			
WELL LOCATION:	Sand	40	95
sec. 30 T. 19 N. R. 8 E 5 miles N of Greenville (distance) (direction) (nearest town)	gravel	95	125
WELL PURPOSE: home (home, irrigation, municipal, industrial)	Clay	125	205
WELL COMPLETION DATA:	Rock.	205	206
(1) diameter (inches) 4x2	Clay st Sand.	206	304
(2) total depth (feet) 450	Rock.	304	306
(3) static water level (feet) 72 below top of ground.	Sand st clay	306	360
(4) casing PVC 430 (material) (depth)	Sand, gravel.	360	400
4x2 If telescope see back. (size)			
(5) screen 20 450-430 (length) (depth to top)			
2" PVC (size) (material)			
(6) pump 2 30 (HP) (yield gpm)			
elect (type power)			
(7) electric log no. (yes or no)			
(organization running log)			
(8) how well bottom plugged back press.			
DRILLERS REMARKS:			

RECEIVED

SEP - 8 1978

MISS. BD. OF WATER COMMISSIONERS


If well telescopes please sketch and show depths.

GROUND LEVEL

140 4"

430 2"

450 2" screen

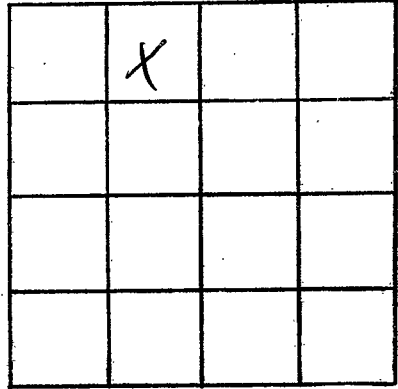

SECTION 30

Please indicate well location X.

ADDITIONAL INFORMATION

If more than one screen, show locations of each on sketch.