

MISSISSIPPI DEPARTMENT OF NATURAL RESOURCES

Bureau of Land and Water Resources

Southport Mall

P.O. Box 10631

Jackson, Mississippi 39209

WATER WELL DRILLERS LOG

Washington  
A 1019  
3/1/81  
1 Mar 1981  
date well completed

firm name

county well located

Lambert Drilling Wash

LANDOWNER:	description of formations encountered	from	to
<u>Charles Wasson</u>			
<u>Greenville, Miss.</u> (mailing/address)	<u>mixed</u>	<u>0</u>	<u>15</u>
WELL LOCATION: sec. <u>29</u> T. <u>19</u> N. R. <u>8</u> E S W	<u>Clay</u>	<u>15</u>	<u>30</u>
<u>1/4</u> miles <u>N</u> of <u>Greenville</u> (distance) (direction) (nearest town)	<u>Sand</u>	<u>30</u>	<u>70</u>
WELL PURPOSE: <u>none</u> (home, irrigation, municipal, industrial)	<u>red gravel</u>	<u>70</u>	<u>105</u>
WELL COMPLETION DATA:	<u>Clay</u>	<u>105</u>	<u>280</u>
(1) diameter (inches) <u>4x2</u>	<u>Clay st Sand</u>	<u>280</u>	<u>470</u>
(2) total depth (feet) <u>525</u>	<u>Sand gravel</u>	<u>470</u>	<u>525</u>
(3) static water level (feet) <u>47</u> below top of ground.			
(4) casing <u>PVC</u> , <u>505</u> (material) (depth)			
<u>4x2</u> If telescope see back. (size)			
(5) screen <u>20</u> , <u>525-505</u> (length) (depth to top)			
<u>2</u> , <u>305 stainless</u> (size) (material)			
(6) pump <u>1</u> , <u>20</u> (HP) (yield gpm)			
<u>elect.</u> (type power)			
(7) electric log (yes or no)			
(organization running log)			
(8) how well bottom plugged <u>back process</u>			
DRILLERS REMARKS:			

DEPT. OF NATURAL RESOURCES  
BUREAU OF LAND & WATER RESOURCES

MAY 18 1981

RECEIVED


If well telescopes please sketch and show depths.

GROUND LEVEL

140 4"

505 2"

525 2" scr.

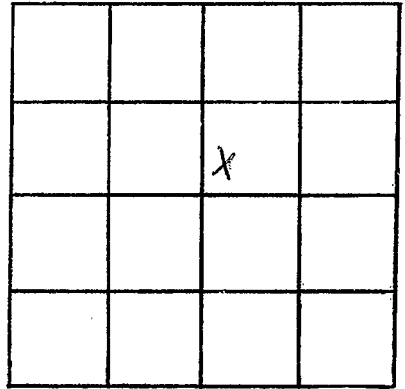

SECTION 29

Please indicate well location X.

ADDITIONAL INFORMATION

If more than one screen, show locations of each on sketch.