

MISSISSIPPI DEPARTMENT OF NATURAL RESOURCES

Bureau of Land and Water Resources

Southport Mall

P.O. Box 10631

Jackson, Mississippi 39209

WATER WELL DRILLERS LOG

WASHINGTON
A 1020
7-26-81

26 July 1981 date well completed Lambert Drilling Co firm name Wash county well located

LANDOWNER:
J. Strickland
Hwy 61 N. Leland Miss.
(mailing address)

WELL LOCATION:
sec. 36 T 19 N R 28 E
S W
6 miles N/W of Leland.
(distance) (direction) (nearest town)

description of formations encountered	depth	
	from	to
Clay	0	30
Sand	30	60
fine gravel	60	140
Grind gravel	140	185
Clay blue	185	300
Clayst Sand	300	390
Sand	390	420
Sand st. clay	420	440
Sand	440	480

WELL PURPOSE: none
(home, irrigation, municipal, industrial)

WELL COMPLETION DATA:

(1) diameter (inches) 4x2

(2) total depth (feet) 480

(3) static water level (feet) 36 below above top of ground.

(4) casing PVC, 460 (material) (depth)
4x2 (size) If telescope see back.

(5) screen 20, 475-460 (length) (depth to top)
2 (size), PVC (material)

(6) pump 1 (HP) 20 (yield gpm)
elect (type power)

(7) electric log (yes or no)

(organization running log)

(8) how well bottom plugged
beck press

DRILLERS REMARKS:

DEPT. OF NATURAL RESOURCES
BUREAU OF LAND & WATER RESOURCES

NOV 20 1981

RECEIVED

If well telescopes please sketch and show depths.


GROUND LEVEL

140 4"

460 2"

480 2" 50'

If more than one screen,
show locations of each on sketch.

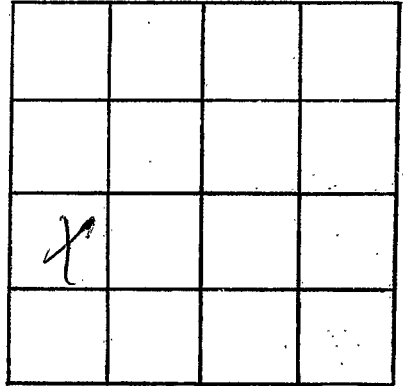

SECTION 36

Please indicate well location X.

ADDITIONAL INFORMATION

Multiple horizontal lines for additional information.