

MISSISSIPPI DEPARTMENT OF NATURAL RESOURCES

Bureau of Land and Water Resources

Southport Mall

P.O. Box 10631

Jackson, Mississippi 39209

WATER WELL DRILLERS LOG

14 May 1982
date well completed

Copper Dillingham Washington
owner name county well located

LANDOWNER: Forkland Farms
@ Piscilla
Greenville MS
(mailing address)

description of formations encountered:	from	to
Clay	0	37
Fine Sand	37	45
Sand & Small Gravel	45	60
Small Gravel	60	85
Gravel	85	110

WELL LOCATION:
sec. B-T-19 N R. 8
1 miles NW of Piscilla
(distance) (direction) (nearest town)

WELL PURPOSE: Center Point
(home, irrigation, municipal, industrial)

WELL COMPLETION DATA:

(1) diameter (inches) 26"

(2) total depth (feet) 110

(3) static water level (feet) 27 below above top of ground.

(4) casing Steel 70'
(material) (depth)
16" if telescope see back.
(size)

(5) screen 40' 70'
(length) (depth to top)
16" 1 1/2" Steel
(size) (material)

(6) pump 80 1800
(HP) (yield gpm)
Diesel
(type power)

(7) electric log No
(yes or no)
No
(organization running log)


(8) had well bottom plugged steel
plato

DRILLERS REMARKS: Pump set @ 60 w/ tall pipe

DEPT. OF NATURAL RESOURCES
 BUREAU OF LAND & WATER RESOURCES
 MAY 28 1982
 RECEIVED

If well telescopes please sketch and show depths.

GROUND LEVEL

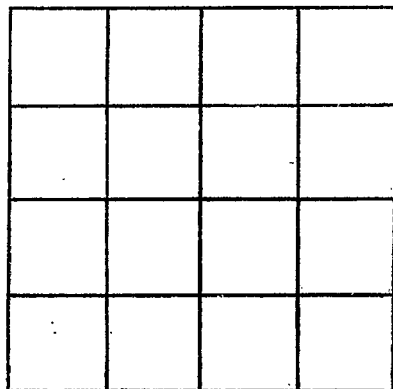

SECTION _____

Please indicate well location X.

ADDITIONAL INFORMATION

If more than one screen,
show locations of each on sketch.