

MISSISSIPPI DEPARTMENT OF NATURAL RESOURCES

Bureau of Land and Water Resources

Southport Mall

P.O. Box 10631

Jackson, Mississippi 39209

WATER WELL DRILLERS LOG

Washington
A 1072

21 May 1982 Coppage Drilling Washington
date well completed film name county well located

LANDOWNER: Warren Davis
@ Lake Ferguson
Greenville, MS 38701
(mailing address)

WELL LOCATION:
sec. 14 T 19 N R 9 W
3 miles E of Greenville
(distance) (direction) (nearest town)

WELL PURPOSE:
(home, irrigation, municipal, industrial)

WELL COMPLETION DATA:
(1) diameter (inches) 6"
(2) total depth (feet) 520
(3) static water level (feet) 27 below top of ground
(4) casing 4" PVC-200 (material) 2" PVC-265 (depth)
4x2 if telescope see back. (size)
(5) screen 15' (length) 465' (depth to top)
2" PVC #10 slot (size) (material)
(6) pump 1/2 (HP) 19 (yield gpm)
230V/1Ph (type power)
(7) electric log None (yes or no)

(organization running log)

(8) how well bottom plugged Wash Valve 2" Brass

DRILLERS REMARKS: Well set @ 480' - Pump set @ 126' on 1" Galv pipe


description of formations encountered	from	to
	Mud	0
Mud	40	360
Sand	60	80
Gravel	80	100
Clay	100	360
Gravel + Rocky Sand	360	400
	400	520

DEPT. OF NATURAL RESOURCES
BUREAU OF LAND & WATER RESOURCES
MAY 26 1982

RECEIVED

If well telescopes please sketch and show depths.

GROUND LEVEL

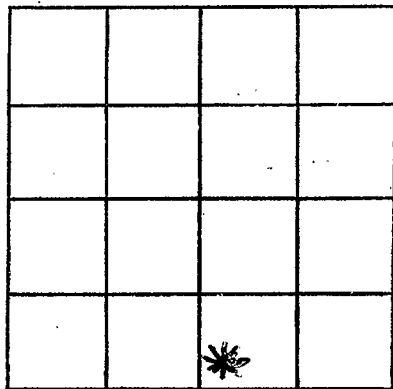

SECTION

14

Please indicate well location X.

ADDITIONAL INFORMATION

If more than one screen,
show locations of each on sketch.