

MISSISSIPPI DEPARTMENT OF NATURAL RESOURCES

Bureau of Land and Water Resources

Southport Mall

P.O. Box 10631

Jackson, Mississippi 39209

WATER WELL DRILLERS LOG

Washington
A 023

16 Jan 19 82 Lambat Dr. N. W. Wash
date well completed firm name county well located

LANDOWNER:	description of formations encountered	from	to
<u>Havley Medical P</u> <u>Medical P, M. 59.</u> (mailing address)			
WELL LOCATION: sec. <u>25</u> T. <u>19</u> N. R. <u>8</u> E <u>6</u> miles <u>N/E</u> of <u>Greenville</u> (distance) (direction) (nearest town)	<u>Clay</u>	<u>15</u>	<u>28</u>
WELL PURPOSE: <u>home</u> (home, irrigation, municipal, industrial)	<u>Sand</u>	<u>28</u>	<u>70</u>
WELL COMPLETION DATA: (1) diameter (inches) <u>4x2</u>	<u>gravel</u>	<u>70</u>	<u>94</u>
(2) total depth (feet) <u>510</u>	<u>Clay</u>	<u>94</u>	<u>210</u>
(3) static water level (feet) <u>46</u> below top of ground.	<u>Clay & sand</u>	<u>210</u>	<u>390</u>
(4) casing <u>PVC</u> <u>490</u> (material) (depth)	<u>Sand & gravel</u>	<u>390</u>	<u>470</u>
<u>4x2</u> (size) if telescope see back.	<u>Sand</u>	<u>470</u>	<u>510</u>
(5) screen <u>20</u> <u>510-490</u> (length) (depth to top)			
<u>2"</u> (size) <u>PVC</u> (material)			
(6) pump <u>1</u> <u>20</u> (HP) (yield gpm)			
<u>elect</u> (type power)			
(7) electric log (yes or no)			
(organization running log)			
(8) how well bottom plugged <u>back press.</u>			
DRILLERS REMARKS:			

DEPT. OF NATURAL RESOURCES
BUREAU OF LAND & WATER RESOURCES
MAY 18 1982
RECEIVED


If well telescopes please sketch and show depths.

GROUND LEVEL

140 4"

490 211

510 2' 50"

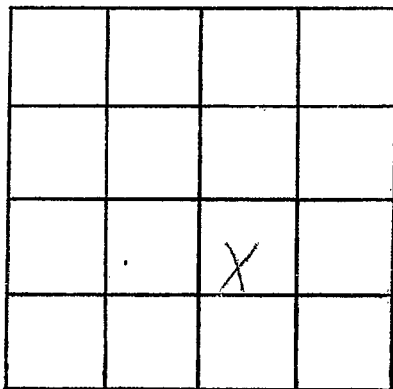

SECTION 25

Please indicate well location X.

ADDITIONAL INFORMATION

If more than one screen, show locations of each on sketch.