

Washington
A 1024

MISSISSIPPI
BOARD OF WATER COMMISSIONERS
416 North State Street
Jackson, Mississippi 39201

WATER WELL DRILLERS LOG

9-13-83
date well completed

19 Schultz Drilling
firm name

Washington
county well located

LANDOWNER: JAMES THOMAS
Greenville MS

description of formations
encountered

from

to

(mailing address)

WELL LOCATION:

sec 9 T 18 N R 8 E
3 miles S of Metairie
(distance) (direction) (nearest town)

WELL PURPOSE: Home
(home, irrigation, municipal, industrial)

WELL COMPLETION DATA:

- (1) diameter (inches) 2"
(2) total depth (feet) 430'
(3) static water level (feet) 65' below
top of ground.
(4) casing PVC 420'
(material) (depth)

- (size) If telescope see back.
(5) screen 10' 420'
(length) (depth to top)

- 2" PVC
(size) (material)
(6) pump 1 10
(HP) (yield gpm)

- ele
(type power)
(7) electric log NO
(yes or no)
X
(organization running log)

- (8) how well bottom plugged b/w


DRILLERS REMARKS:

DEPT. OF NATURAL RESOURCES
BUREAU OF LAND & WATER RESOURCES

SEP 26 1983
RECEIVED

If well telescopes please
sketch and show depths.

GROUND LEVEL

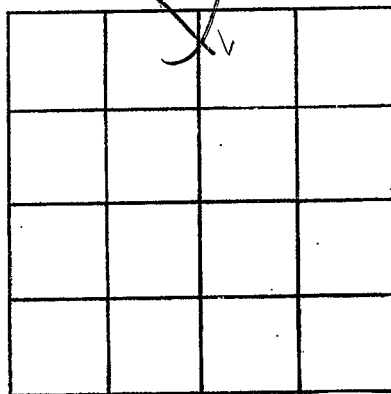

SECTION 9

Please indicate well location X.

ADDITIONAL INFORMATION

If more than one screen,
show locations of each on sketch.