

MISSISSIPPI DEPARTMENT OF NATURAL RESOURCES

Bureau of Land and Water Resources

Southport Mall

P.O. Box 10631

Jackson, Mississippi 39209

WATER WELL DRILLERS LOG

Washington  
A 1025

10/5

1983

Coppage Drilling Wash

date well completed

firm name

county well located

LANDOWNER: Pat Parkin

description of formations encountered

from

to

LAKE FERGUSON Rd

Clay  
SAND

0 18

Curtis Ms.  
(mailing address)

GRAVEL & SAND

18 70

WELL LOCATION:

Mud

70 105

sec. 32 T. 19 S. R. 8 E.  
2 miles N of GREENVILLE  
(distance) (direction) (nearest town)

Rock

105 280

Mud

280 280.5

SAND

280.5 440

440 470

WELL PURPOSE: Domestic  
(home, irrigation, municipal, industrial)

WELL COMPLETION DATA:

- (1) diameter (inches) 4x2
- (2) total depth (feet) 470
- (3) static water level (feet) 217 below above top of ground.
- (4) casing POC 455  
(material) (depth)  
4x2 if telescope see back.  
(size)
- (5) screen 15 455  
(length) (depth to top)  
2" POC  
(size) (material)
- (6) pump 1 21  
(HP) (yield gpm)  
Electric  
(type power)
- (7) electric log X  
(yes or no)

(organization running log)

(8) how well bottom plugged Drill Wash Valve

DRILLERS REMARKS:


MISSISSIPPI DEPT. OF NATURAL RESOURCES  
BUREAU OF LAND & WATER RESOURCES

NOV 16 1983

RECEIVED

If well telescopes please sketch and show depths.

GROUND LEVEL

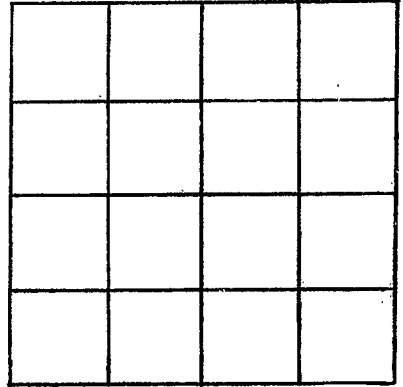

SECTION \_\_\_\_\_

Please indicate well location X.

ADDITIONAL INFORMATION

If more than one screen,  
show locations of each on sketch.