

MISSISSIPPI DEPARTMENT OF NATURAL RESOURCES

Bureau of Land and Water Resources

Southport Mall

P.O. Box 10631

Jackson, Mississippi 39209

WATER WELL DRILLERS LOG

Washington  
A 1026

Not  
Recorded  
due to  
Hole  
Coppage Drilling Inc

18 March 1982 date well completed  
Coppage Drilling Inc firm name  
Washington county well located

LANDOWNER: Forkland Farms  
Route 1, Box 508  
Greenville MS 38701  
(mailing address)

description of formations encountered	from	to
Clay	0	38'
Med. Sand	38'	60'
Coarse Sand	60	80'
Gravel & Sand	80	102'
Med Gravel	102	130'

WELL LOCATION:  
sec. 3 T 19 N R 8 E  
10 miles North of Greenville  
(distance) (direction) (nearest town)

WELL PURPOSE: TEST HOLE  
(home, irrigation, municipal, industrial)

WELL COMPLETION DATA:

- (1) diameter (inches) 6
- (2) total depth (feet) 130
- (3) static water level (feet) NA below above top of ground.
- (4) casing None  
(material) (depth)  
         if telescope see back.  
(size)
- (5) screen None  
(length) (depth to top)  
         (size) (material)
- (6) pump None  
(HP) (yield gpm)  
         (type power)
- (7) electric log None  
(yes or no)  
         (organization running log)
- (8) how well bottom plugged None

DRILLERS REMARKS: Capable  
2500 GPM


DEPT. OF NATURAL RESOURCES  
BUREAU OF LAND & WATER RESOURCES

MAR 26 1982

RECEIVED

If well telescopes please sketch and show depths.

GROUND LEVEL

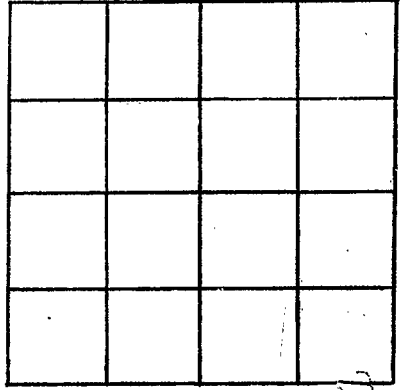

SECTION \_\_\_\_\_

Please indicate well location X.

ADDITIONAL INFORMATION

If more than one screen, show locations of each on sketch.