

MISSISSIPPI DEPARTMENT OF NATURAL RESOURCES

Bureau of Land and Water Resources

Southport Mall

P.O. Box 10631

Jackson, Mississippi 39209

WATER WELL DRILLERS LOG

A 2000
Washington

1/03/85
date well completed

19

CHICOT IRRIGATION
firm name

WASHINGTON
county well located


LANDOWNER: BLACK MOUNTAIN Inc.	description of formations encountered	from	to
(mailing address)	Top Soil and Clay	0	10
WELL LOCATION:	Fine Sand	10	20
sec. 17 T. 19 N. R. 8 E. W. 1/4 miles E of Waterville (distance) (direction) (nearest town)	Gravel and Sand	20	107
WELL PURPOSE: Home (home, irrigation, municipal, industrial)	Clay	107	320
WELL COMPLETION DATA:	Fine Sand	320	360
(1) diameter (inches) 4" x 2"	Clay	360	400
(2) total depth (feet) 480	Clay and Sand	400	440
(3) static water level (feet) 20 below top of ground.	Gravel Sand Formation	440	480
(4) casing 4" (material), 120 (depth), 2" (size) if telescope see back.			
(5) screen 8 ft. 2" S.S. (length) (depth to top)			
(6) pump 1/2 (HP), 10 (yield gpm)			
(7) electric log (yes or no)			
(8) how well bottom plugged End Cap			
DRILLERS REMARKS:			

RECEIVED
MAR 14 1985

Department of Natural Resources
Bureau of Land & Water Resources

If well telescopes please
sketch and show depths.

GROUND LEVEL

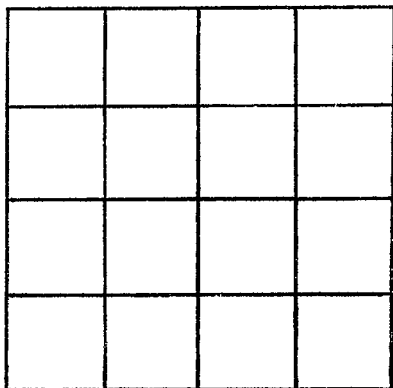

SECTION _____

Please indicate well location X.

ADDITIONAL INFORMATION

If more than one screen,
show locations of each on sketch.