

MISSISSIPPI DEPARTMENT OF NATURAL RESOURCES

Bureau of Land and Water Resources

Southport Mall

P.O. Box 10631

Jackson, Mississippi 39209

WATER WELL DRILLERS LOG

WASHINGTON
Monitor well
B-3
A 0000

10-27 1986 Schultz Drilling Washington  
 date well completed firm name county well located

LANDOWNER: Breing of Ms Inc  
 Greenville Municipal Airport  
 Greenville Ms  
 (mailing address)

description of formations encountered	from to	
clay	0	27
sand	27	38

WELL LOCATION:  
 sec. 14 T 19 N R 8 E  
 5 miles N of Greenville  
 (distance) (direction) (nearest town)

WELL PURPOSE: Monitor  
 (home, irrigation, municipal, industrial)

- WELL COMPLETION DATA:
- (1) diameter (inches) 2"
  - (2) total depth (feet) 38'
  - (3) static water level (feet) 21' below top of ground
  - (4) casing PVC, 28' (material), (depth)  
 2" (size) if telescope see back.
  - (5) screen 10' 28' (length), (depth to top)  
 2" PVC (size), (material)
  - (6) pump 0 0 (HP), (yield gpm)  
 0 (type power)
  - (7) electric log no (yes or no)  
 (organization running log)
  - (8) how well bottom plugged cap

RECEIVED


FEB 06 1987

Department of Natural Resources  
 Bureau of Land & Water Resources

DRILLERS REMARKS:

If well telescopes please sketch and show depths.

GROUND LEVEL

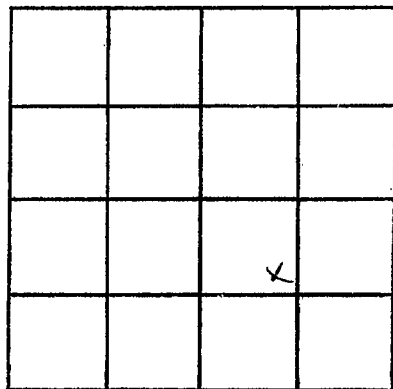

SECTION 10

Please indicate well location X.

ADDITIONAL INFORMATION

If more than one screen,  
show locations of each on sketch.