

MISSISSIPPI DEPARTMENT OF NATURAL RESOURCES

Bureau of Land and Water Resources

Southport Mall

P.O. Box 10631

Jackson, Mississippi 39209

WATER WELL DRILLERS LOG

WASHINGTON  
Monitor Well  
B-6  
A 2003

16-27  
date well completed

1986 Schultz Drilling  
firm name

Washington  
county well located

LANDOWNER: Boeing of MS Inc  
Greenville Municipal Airport  
Greenville, MS  
(mailing address)

description of formations encountered

from

to

clay  
sand

0 32  
32 42

WELL LOCATION:

sec. 14 T 19 N R 8 E  
5 miles N of Greenville  
(distance) (direction) (nearest town)

WELL PURPOSE: monitor  
(home, irrigation, municipal, industrial)

WELL COMPLETION DATA:

- (1) diameter (inches) 2"
- (2) total depth (feet) 42'
- (3) static water level (feet) 21' (below) above top of ground
- (4) casing PVC 32' (material) (depth)
- 2" (size) if telescope see back.
- (5) screen 10' 30' (length) (depth to top)
- 2" (size) PVC (material)
- (6) pump (HP) (yield gpm)
- (type power)
- (7) electric log no (yes or no)

RECEIVED

FEB 06 1987


Department of Natural Resources  
Bureau of Land & Water Resources

(organization running log)  
(8) how well bottom plugged cap

DRILLERS REMARKS:

If well telescopes please  
sketch and show depths.

GROUND LEVEL

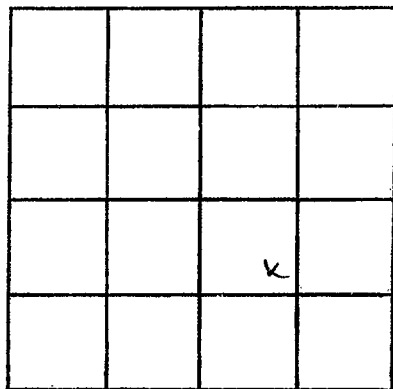

SECTION 14

Please indicate well location X.

ADDITIONAL INFORMATION

If more than one screen,  
show locations of each on sketch.