

MISSISSIPPI DEPARTMENT OF NATURAL RESOURCES

Bureau of Land and Water Resources

Southport Mall

P.O. Box 10631

Jackson, Mississippi 39209

WATER WELL DRILLERS LOG

WASHINGTON
Monitor Well
B-1
A 2005

10-27 1986 Schultz Drilling Washington
 date well completed firm name county well located

LANDOWNER: Boeing of Ms Inc
Greenville Municipal Airport
Greenville, MS
 (mailing address)

description of formations encountered	from	to
	<u>clay sand</u>	<u>0</u>
	<u>25</u>	<u>38</u>

WELL LOCATION:
 sec. 14 T. 19 N R. 8 E
5 miles N of Greenville
 (distance) (direction) (nearest town)

WELL PURPOSE: monitor
 (home, irrigation, municipal, industrial)

WELL COMPLETION DATA:

(1) diameter (inches) 2 1/4"

(2) total depth (feet) 38'

(3) static water level (feet) 2' below above top of ground.


(4) casing PVC, 28',
 (material) (depth)
2 1/4" if telescope see back.
 (size)

(5) screen 10', 28'
 (length) (depth to top)
2", PVC
 (size) (material)

(6) pump 0 0
 (HP) (yield gpm)
0
 (type power)

(7) electric log no
 (yes or no)

(8) how well bottom plugged cap

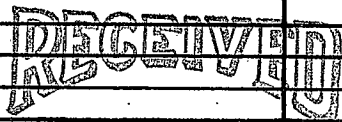


FEB 06 1987

Department of Natural Resources
 Bureau of Land & Water Resources

DRILLERS REMARKS:

If well telescopes please
sketch and show depths.

GROUND LEVEL

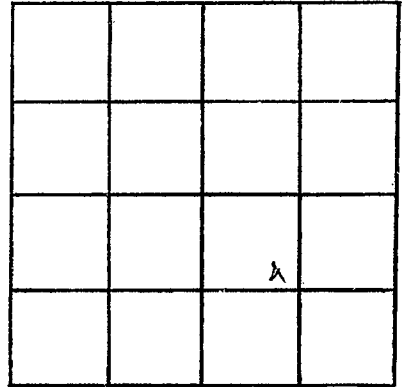

SECTION sd

Please indicate well location X.

ADDITIONAL INFORMATION

If more than one screen,
show locations of each on sketch.