

MISSISSIPPI DEPARTMENT OF NATURAL RESOURCES

Bureau of Land and Water Resources

Southport Mall

P.O. Box 10631

Jackson, Mississippi 39209

WATER WELL DRILLERS LOG

WASHINGTON
monitor well
B-7
A 2000

10-21 1986
date well completed

Schultz Drilling
firm name

Washington
county well located

LANDOWNER: Boeing of Ms, Inc
Greenville Municipal Airport
Greenville, MS
(mailing address)

description of formations encountered

from

to

clay
sand

0 17
17 27


WELL LOCATION:

sec. 14 T 19 N R 8 E
5 miles N of Greenville
(distance) (direction) (nearest town)

WELL PURPOSE: monitor
(home, irrigation, municipal, industrial)

WELL COMPLETION DATA:

- (1) diameter (inches) 2"
- (2) total depth (feet) 27'
- (3) static water level (feet) 21' below above top of ground.
- (4) casing PVC 17' (material) (depth)
2" (size) if telescope see back.
- (5) screen 10' 17' (length) (depth to top)
2" PVC (size) (material)
- (6) pump (HP) (yield gpm)
(type power)
- (7) electric log NO (yes or no)
(organization running log)
- (8) how well bottom plugged cap

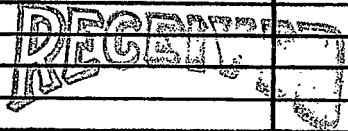


FEB 06 1987

Department of Natural Resources
Bureau of Land & Water Resources

DRILLERS REMARKS:

If well telescopes please
sketch and show depths.

GROUND LEVEL

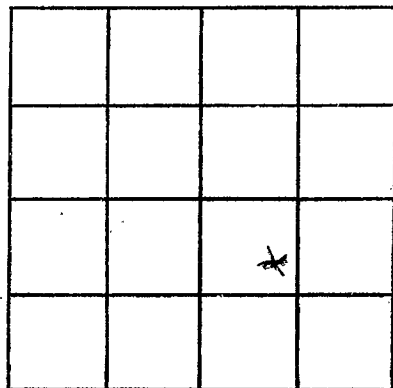

SECTION 14

Please indicate well location X.

ADDITIONAL INFORMATION

If more than one screen,
show locations of each on sketch.