

MISSISSIPPI DEPARTMENT OF NATURAL RESOURCES

Bureau of Land and Water Resources

Southport Mail

P.O. Box 10631

Jackson, Mississippi 39209

WATER WELL DRILLERS LOG

WASHINGTON
 Monitor Well
 B-4
 A 2007

10-27-79 date well completed 816 Schultz Drilling firm name Washington county well located

LANDOWNER: Boeing of MS, Inc
 Greenville Municipal Airport
 Greenville, MS
 (mailing address)

description of formations encountered

from

to

clay
 sand

0 30
 20 40

WELL LOCATION:

sec. 14 T. 19 N R. 8 E
 S W
 5 miles N of Greenville
 (distance) (direction) (nearest town)

WELL PURPOSE: monitor
 (home, irrigation, municipal, industrial)

WELL COMPLETION DATA:

- (1) diameter (inches) 2"
- (2) total depth (feet) 40'
- (3) static water level (feet) 31' below top of ground.
- (4) casing PVC 30' (material), (depth), 2" (size) if telescope see back.
- (5) screen 10' 30' (length), (depth to top) 2" PVC (size), (material)
- (6) pump -- (HP) -- (yield gpm) -- (type power)
- (7) electric log no (yes or no)
- (8) how well bottom plugged cap

RECEIVED


FEB 06 1987

Department of Natural Resources
 Bureau of Land & Water Resources

DRILLERS REMARKS:

If well telescopes please
sketch and show depths.

GROUND LEVEL

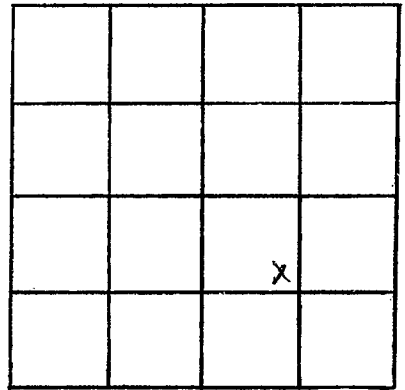

SECTION 14

Please indicate well location X.

ADDITIONAL INFORMATION

If more than one screen,
show locations of each on sketch.