

MISSISSIPPI DEPARTMENT OF NATURAL RESOURCES

Bureau of Land and Water Resources

Southport Mall

P.O. Box 10631

Jackson, Mississippi 39209

WATER WELL DRILLERS LOG

WASHINGTON
Montbe Well
B-2
A 2010

10-27 1986 date well completed Schulte Drilling firm name Washington county well located

LANDOWNER: Boeing of Ms Inc Greenville Municipal Airport Greenville Ms (mailing address)	description of formations encountered	from	to
	clay same	0 28	28 39
WELL LOCATION: sec. 14 T. 19 N. R. 8 E. W. 5 (distance) miles (direction) of Greenville (nearest town)			
WELL PURPOSE: monitor (home, irrigation, municipal, industrial)			
WELL COMPLETION DATA: (1) diameter (inches) 2" (2) total depth (feet) 39' (3) static water level (feet) 21' below top of ground. (4) casing PVC, 29' (material), (depth) 2" (size) If telescope see back. (5) screen 10' (length), 29' (depth to top) 2" PVC (size), (material) (6) pump 0 (HP), 0 (yield gpm) 0 (type power) (7) electric log no (yes or no) (organization running log) (8) how well bottom plugged cap			
DRILLERS REMARKS:			


RECEIVED

FEB 06 1987

Department of Natural Resources
Bureau of Land & Water Resources

If well telescopes please sketch and show depths.

GROUND LEVEL

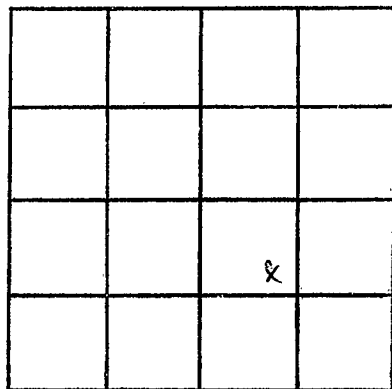

SECTION rel

Please indicate well location X.

ADDITIONAL INFORMATION

If more than one screen, show locations of each on sketch.