

MISSISSIPPI DEPARTMENT OF NATURAL RESOURCES

Bureau of Land and Water Resources

Southport Mall

P.O. Box 10631

Jackson, Mississippi 39209

WATER WELL DRILLERS LOG

~~Boonville~~  
~~Washington~~  
 A 2012

14 Feb 1987  
 date well completed

Lambert Drilling  
 firm name

~~Bellevue~~  
 county well located

LANDOWNER:	description of formations encountered	from	to
T.J. Pinnix			
Benoit, Miss. (mailing address)	Clay	0	20
WELL LOCATION:	Sand	20	80
sec. <u>1</u> T <u>19</u> N S R <u>8</u> E W	pea gravel	80	210
<u>12</u> miles <u>N</u> of <u>Greenville</u> (distance) (direction) (nearest town)	Clay	210	330
WELL PURPOSE: <u>home</u> (home, irrigation, municipal, industrial)	Sand st clay	330	390
WELL COMPLETION DATA:	Sand Pine	390	440
(1) diameter (inches) <u>4 1/2"</u>	Sand	440	500
(2) total depth (feet) <u>500</u>			
(3) static water level (feet) <u>56</u> below above top of ground.			
(4) casing <u>PVC</u> (material) (depth) <u>2</u> (size) If telescope see back.			
(5) screen <u>20</u> (length) <u>500-480</u> (depth to top)			
<u>2</u> (size) <u>PVC</u> (material)			
(6) pump <u>1</u> (HP) <u>16</u> (yield gpm) <u>elect</u> (type power)			
(7) electric log <u>no</u> (yes or no)			
(organization running log)			
(8) how well bottom plugged <u>back press.</u>			
DRILLERS REMARKS:			


RECEIVED

FEB 18 1987

Department of Natural Resources  
 Bureau of Land & Water Resources

If well telescopes please sketch and show depths.

GROUND LEVEL

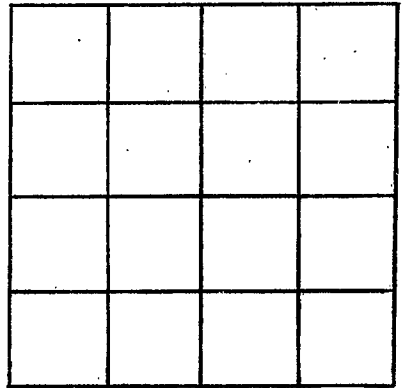

SECTION \_\_\_\_\_

Please indicate well location X.

ADDITIONAL INFORMATION

If more than one screen, show locations of each on sketch.