

MISSISSIPPI DEPARTMENT OF NATURAL RESOURCES

Bureau of Land and Water Resources

Southport Mall

P.O. Box 10631

Jackson, Mississippi 39209

WATER WELL DRILLERS LOG

WASHINGTON
A 2016

6-25 1987
date well completed

Schultz Drilling
firm name

Washington
county well located

LANDOWNER: Mrs. Wendell Hines
Rt. 3 Box 706A.

Greenville, MS
(mailing address)

WELL LOCATION:

sec. 14 T 19 S R 9 E
6 miles N of Greenville
(distance) (direction) (nearest town)

WELL PURPOSE: Home
(home, irrigation, municipal, industrial)

WELL COMPLETION DATA:

- (1) diameter (inches) 4" x 2"
- (2) total depth (feet) 420'
- (3) static water level (feet) 48' below top of ground.
- (4) casing PVC, 400' (material) (depth)
if telescope see back.
- (5) screen 20' 400' (length) (depth to top)
2" PVC (size) (material)
- (6) pump 1 20 (HP) (yield gpm)
ele (type power)
- (7) electric log No (yes or no)
X (organization running log)
- (8) how well bottom plugged b/w

description of formations encountered	from	to
CLAY	0	20
COARSE SAND	20	60
SAND + gravel	60	110
CLAY SAND	110	340
	340	420



RECEIVED

JUL 13 1987

Dept. of Natural Resources
Bureau of Land & Water Resources

DRILLERS REMARKS:

If well telescopes please sketch and show depths.

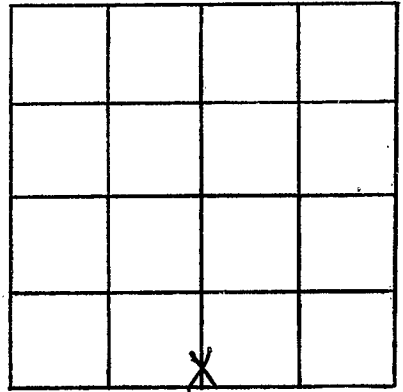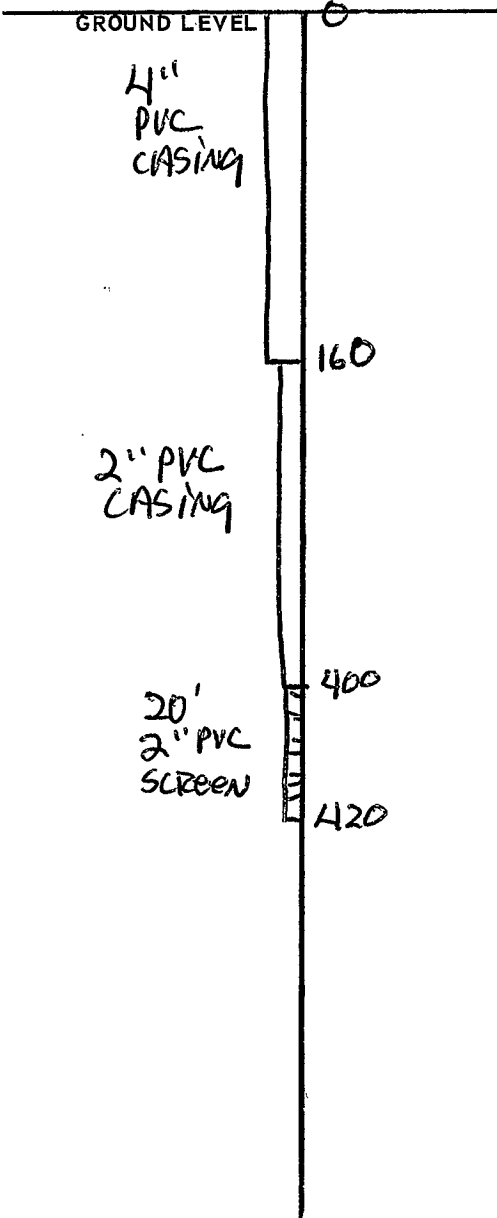

SECTION 14

Please indicate well location X.

ADDITIONAL INFORMATION

A series of horizontal lines for recording additional information.

If more than one screen, show locations of each on sketch.