

WASHINGTON
A 2017

MISSISSIPPI DEPARTMENT OF NATURAL RESOURCES
Bureau of Land and Water Resources
Southport Mall
P.O. Box 10631
Jackson, Mississippi 39209
WATER WELL DRILLERS LOG

6-24 1987
date well completed

Schultz Drilling Washington
firm name county well located

LANDOWNER: LYNN Crawford
Sally Ferguson Rd.
Sumville, Mo 38701
(mailing address)

description of formations encountered	from	to
Topsoil	0	20
SAND	20	100
PEA gravel	100	120
ROCK	120	122
CLAY	122	300
SHALE	300	360
SAND	360	420

WELL LOCATION:
sec. 14 T. 19 S. R. 8 E
4 miles N of Greaville
(distance) (direction) (nearest town)

WELL PURPOSE: HOME
(home, irrigation, municipal, industrial)

WELL COMPLETION DATA:

- (1) diameter (inches) 2"
- (2) total depth (feet) 420'
- (3) static water level (feet) 51' - below top of ground.
- (4) casing PVC 410'
(material) (depth)
- (5) screen 10' 410'
(length) (depth to top)
2" PVC
(size) (material)
- (6) pump 1 10
(HP) (yield gpm)
elf
(type power)
- (7) electric log NO
(yes or no)
X
(organization running log)
- (8) how well bottom plugged b/w

DRILLERS REMARKS:


RECEIVED

OCT 05 1987

Department of Natural Resources
Bureau of Land & Water Resources

If well telescopes please sketch and show depths.

GROUND LEVEL

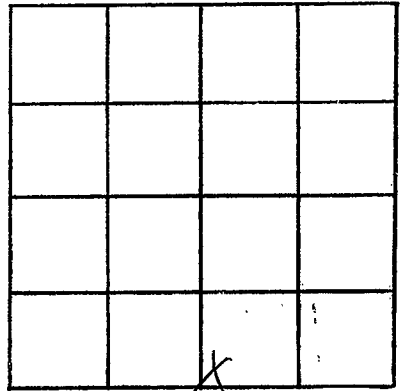

SECTION 14

Please indicate well location X.

ADDITIONAL INFORMATION

If more than one screen, show locations of each on sketch.