

MISSISSIPPI DEPARTMENT OF NATURAL RESOURCES

Bureau of Land and Water Resources

P.O. Box 10631

Jackson, Mississippi 39209

WATER WELL DRILLERS LOG

COUNTY WELL LOCATED
WASHINGTON

WELL NUMBER **A** CODED

DATE WELL COMPLETED
2001 3-5-90

145139146A

PERMIT NUMBER
6224 ?

NAME OF DRILLING FIRM
IRRIGATION EQUIPMENT.

601/887-2555

INDIANOLA, MS

NAME & MAILING ADDRESS OF LANDOWNER
Luther OAKES

101 KAREN ST.

Greenville, MS 38701

WELL LOCATION: SEC **27** TOWNSHIP **19^S** RANGE **8^E**

DISTANCE **2** Miles DIRECTION **NORTH** of NEAREST TOWN **Greenville**

OTHER LANDMARK

WELL PURPOSE: Home, Irrigation, Municipal, Industrial, Fish Pond, etc.
IRRIGATION

PUMP DATA

PUMP TYPE (Circle One):
Submersible, **Turbine** Jet Flowing Well,
Other (Describe)

POWER TYPE (Circle One):
Electric, Tractor, **Diesel** Gasoline, Butane,
Other (Describe) H/P **60**

Pump Capacity (GPM) **3000** No. of Stages **1** Setting Depth **60** FT.

PUMP TEST

Well yielded _____ GPM with
a drawdown of _____ ft.
after _____ hours of pumping

WELL DATA

Well Depth 100	Casing Diameter (In.) 16	Casing Length (Ft.) 60
Type of Casing Steel	Hole Depth 100	Depth to Static Water Level 8'

TYPE OF COMPLETION: (Circle One or More):
Gravel Packed Underreamed, Telescoped,
Natural Development, Open Hole, Other

Top of Lap Pipe or Reduction in Casing

FEET IF TELESCOPED OR MORE THAN ONE SCREEN: USE BACK PAGE

LOG DATA

TYPE OF LOG RUN (Circle One):
No Log Run, Electric, Gamma Ray, Density, Sonic, Neutron,
Other (Describe)

Name of Organization Running Log

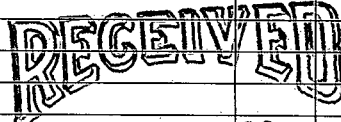
SCREEN DATA

Diameter - Inches 16	Length - Feet 40	Slot Size - Inches 0060
Screen Type Steel	Depth to Bottom - Feet 100	

GEOLOGIC DATA (Office Use Only)

Surface Elev.	Geologic Unit	Unit Thickness	Depth to Top
Subs. SWL	Date	Analysis	Aquifer Test

Driller's Remarks

DESCRIPTION OF FORMATIONS ENCOUNTERED	FROM	TO	FORMATIONS (Continued)	FROM	TO
Fine sand	0	40	 MAR 09 1990 Department of Natural Resources Bureau of Land & Water Resources		
COARSE SAND	40	80			
COARSE SAND + gravel	80	90			
COARSE sand	90	100			

IF MORE SPACE IS NEEDED, USE BACK

If well telescopes please sketch and show depths.

GROUND LEVEL

			X

SECTION 27

Please indicate well location X.

ADDITIONAL INFORMATION

If more than one screen, show location of each on sketch.