

MISSISSIPPI DEPARTMENT OF ENVIRONMENTAL QUALITY

Office of Land and Water Resources

P. O. Box 10631
Jackson, MS 39289-0631
WATER WELL DRILLERS LOG

COUNTY WELL LOCATED <i>Wash</i>	
WELL NUMBER <i>A</i>	CODED
DATE WELL COMPLETED <i>1 sept 94</i>	

PERMIT NUMBER
NAME OF DRILLING FIRM <i>Lambert Drilling</i>

NAME & MAILING ADDRESS OF LANDOWNER <i>JOSE WILLKINSON</i>			
<i>Winterville, MS.</i>			
WELL LOCATION:	SEC	TOWNSHIP	RANGE
	<i>3</i>	<i>10</i>	
	<i>3</i>	<i>19</i>	<i>8</i>
		<i>N</i>	<i>E</i>
		<i>S</i>	<i>W</i>
DISTANCE	DIRECTION	NEAREST TOWN	
<i>1</i> Miles	<i>n</i>	of <i>Winterville</i>	
OTHER LANDMARK			
WELL PURPOSE: <u>Home</u> , Irrigation, Municipal, Industrial, Fish Pond, etc.			

PUMP DATA		
PUMP TYPE (Circle One): <u>Submersible</u> , Turbine, Jet, Flowing Well, Other (Describe) _____		
POWER TYPE (Circle One): <u>Electric</u> , Tractor, Diesel, Gasoline, Butane, Other (Describe) _____ H/P <u>1</u>		
Pump Capacity (GPM)	No. of Stages	Setting Depth
<i>20</i>	<i>9</i>	<i>105</i> FT.
PUMP TEST		
Well yielded _____ GPM with a drawdown of _____ ft. after _____ hours of pumping		

WELL DATA		
Well Depth <i>580</i>	Casing Diameter (In.) <i>4 1/2</i>	Casing Length (Ft.) <i>560</i>
Type of Casing <i>PVC</i>	Hole Depth <i>580</i>	Depth to Static Water Level <i>42</i>
TYPE OF COMPLETION: (Circle One or More): <u>Gravel Packed</u> , Underreamed, Telescoped, <u>Natural Development</u> , Open Hole, Other (Describe) _____		

LOG DATA	
TYPE OF LOG RUN (Circle One): Electric, Gamma Ray, Density, Sonic, Neutron, Other (Describe) _____ No Log Run,	
Name of Organization Running Log	

WELL GROUTED TO A DEPTH OF <u>10 FEET</u>
Type Grout (circle one): Cement, Bentonite, or <u>Mix</u>

GEOLOGIC DATA (Office Use Only)			
Surface Elev.	Geologic Unit	Unit Thickness	Depth to Top
Subs. SWL	Date	Analysis	Aquifer Test

SCREEN DATA		
Diameter - Inches <i>2 1/2</i>	Length - Feet <i>20</i>	Slot Size - Inches <i>10</i>
Screen Type <i>PVC rapped</i>	Depth to Bottom - Feet <i>580-560</i>	

Driller's Remarks

DESCRIPTION OF FORMATIONS ENCOUNTERED	FROM	TO	FORMATIONS (Continued)	FROM	TO
<i>mixed</i>	<i>0</i>	<i>20</i>			
<i>Clay</i>	<i>20</i>	<i>80</i>			
<i>Red gravel</i>	<i>80</i>	<i>104</i>			
<i>Clay</i>	<i>104</i>	<i>180</i>			
<i>Clay w/ sand</i>	<i>180</i>	<i>240</i>			
<i>Sand st.</i>	<i>240</i>	<i>300</i>			
<i>Sand.</i>	<i>300</i>	<i>580</i>			

RECEIVED

AUG 18 1994

Dept. of Environmental Quality
Office of Land & Water Resources

IF MORE SPACE IS NEEDED, USE BACK


If well telescopes please sketch and show depths.

GROUND LEVEL

140 4"

560 2'

580 2" sc.

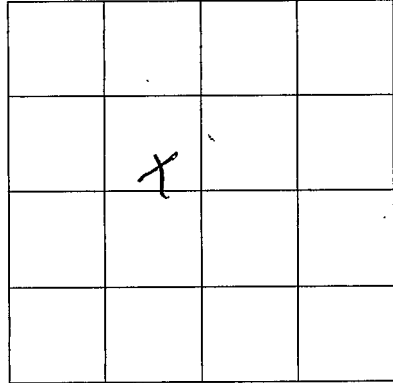

SECTION _____

Please indicate well location X.

ADDITIONAL INFORMATION

If more than one screen,
show location of each on sketch.