

MISSISSIPPI DEPARTMENT OF ENVIRONMENTAL QUALITY

Office of Land and Water Resources

P. O. Box 10631
Jackson, MS 39289-0631
WATER WELL DRILLERS LOG

COUNTY WELL LOCATED <i>Washington</i>	
WELL NUMBER <i>A 2032</i>	CODED
DATE WELL COMPLETED <i>5-20-98</i>	

PERMIT NUMBER
NAME OF DRILLING FIRM <i>Schudco Ltd</i>

NAME & MAILING ADDRESS OF LANDOWNER <i>Terral Seed</i>		
<i>Greenville MS 38701</i>		
WELL LOCATION: SEC	TOWNSHIP	RANGE
<i>1</i>	<i>19 N S</i>	<i>8 E W</i>
DISTANCE	DIRECTION	NEAREST TOWN
<i>1/2</i> Miles	<i>N</i>	<i>Priscilla</i>
OTHER LANDMARK <i>2 mile north of Gville A.P.</i>		
WELL PURPOSE: Home, Irrigation, Municipal, Industrial, Fish Pond, etc.		

PUMP DATA		
PUMP TYPE (Circle One): Submersible, <u>Turbine</u> , Jet, Flowing Well, Other (Describe) _____		
POWER TYPE (Circle One): Electric, Tractor, <u>Diesel</u> , Gasoline, Butane, Other (Describe) _____ H/P <i>40</i>		
Pump Capacity (GPM) <i>2000</i>	No. of Stages <i>1</i>	Setting Depth <i>60</i> FT.
PUMP TEST		
Well yielded _____ GPM with a drawdown of _____ ft. after _____ hours of pumping		

WELL DATA		
Well Depth <i>110</i>	Casing Diameter (In.) <i>16</i>	Casing Length (Ft.) <i>70</i>
Type of Casing <i>pvc</i>	Hole Depth <i>110</i>	Depth to Static Water Level
TYPE OF COMPLETION: (Circle One or More): <u>Gravel Packed</u> , Underreamed, Telescoped, Natural Development, Open Hole, Other		

LOG DATA	
TYPE OF LOG RUN (Circle One): Electric, Gamma Ray, Density, Sonic, <u>No Log Run</u> , Neutron, Other (Describe) _____	
Name of Organization Running Log	

WELL GROUTED TO A DEPTH OF _____ FEET
Type Grout (circle one): Cement, Bentonite, or Mix

GEOLOGIC DATA (Office Use Only)			
Surface Elev.	Geologic Unit	Unit Thickness	Depth to Top
Subs. SWL	Date	Analysis	Aquifer Test
Driller's Remarks <i>07-09-98 AUG 01 RCVD</i>			
Top of Lap Pipe or Reduction in Casing			
FEET		IF TELESCOPED OR MORE THAN ONE SCREEN: USE BACK PAGE	


SCREEN DATA		
Diameter - Inches <i>16</i>	Length - Feet <i>40</i>	Slot Size - Inches <i>.032</i>
Screen Type <i>pvc</i>	Depth to Bottom - Feet <i>110</i>	

DESCRIPTION OF FORMATIONS ENCOUNTERED	FROM	TO	FORMATIONS (Continued)	
			FROM	TO
<i>Gumbo clay</i>	<i>0</i>	<i>14</i>		
<i>fine to med sand</i>	<i>14</i>	<i>30</i>		
<i>med to coarse sand</i>	<i>30</i>	<i>50</i>		
<i>Coarse sand + little gravel</i>	<i>50</i>	<i>90</i>		
<i>Coarse sand + little gravel</i>	<i>90</i>	<i>110</i>		

IF MORE SPACE IS NEEDED, USE BACK

If well telescopes please
sketch and show depths.

GROUND LEVEL

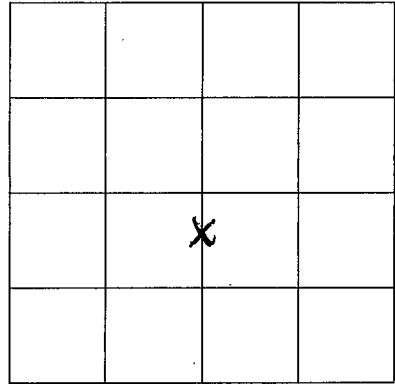

SECTION 1

Please indicate well location X.

ADDITIONAL INFORMATION

If more than one screen,
show location of each on sketch.