




If well telescopes please sketch and show depths.

GROUND LEVEL

740 411

400 211

420 2150V1

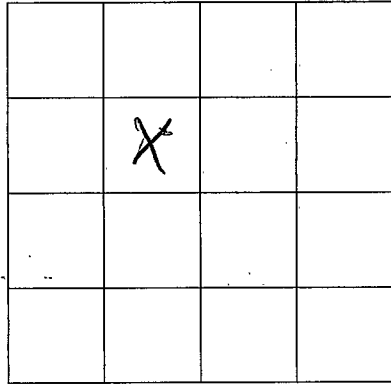

SECTION 16

Please indicate well location X.

ADDITIONAL INFORMATION

If more than one screen, show location of each on sketch.