

MISSISSIPPI DEPARTMENT OF ENVIRONMENTAL QUALITY

Office of Land and Water Resources

P. O. Box 10631  
Jackson, MS 39289-0631  
WATER WELL DRILLERS LOG

COUNTY WELL LOCATED  
Washington

WELL NUMBER A 7036

DATE WELL COMPLETED  
7-28-98

PERMIT NUMBER

NAME OF DRILLING FIRM  
Schudco Ltd

NAME & MAILING ADDRESS OF LANDOWNER  
Emery Skelton  
Winterville  
9MS 38782

WELL LOCATION: SEC 19 TOWNSHIP 19 RANGE 9 N S E W

DISTANCE 3 Miles DIRECTION West of NEAREST TOWN Winterville

OTHER LANDMARK

WELL PURPOSE:  Home Irrigation,  Municipal,  Industrial,  Fish Pond, etc.

PUMP DATA

PUMP TYPE (Circle One): Submersible, Turbine, Jet, Flowing Well, Other (Describe) \_\_\_\_\_

POWER TYPE (Circle One): Electric, Tractor, Diesel, Gasoline, Butane, Other (Describe) \_\_\_\_\_ H/P 3

Pump Capacity (GPM) 60 No. of Stages \_\_\_\_\_ Setting Depth 105 FT.

PUMP TEST

Well yielded \_\_\_\_\_ GPM with a drawdown of \_\_\_\_\_ ft. after \_\_\_\_\_ hours of pumping

WELL DATA

Well Depth <u>500</u>	Casing Diameter (In.) <u>4x3</u>	Casing Length (Ft.) <u>460</u>
Type of Casing <u>pvc</u>	Hole Depth <u>500</u>	Depth to Static Water Level

LOG DATA

TYPE OF LOG RUN (Circle One): No Log Run, Electric, Gamma Ray, Density, Sonic, Neutron, Other (Describe) \_\_\_\_\_

Name of Organization Running Log

TYPE OF COMPLETION: (Circle One or More):  
 Gravel Packed,  Underreamed,  Telescoped,  Natural Development,  Open Hole,  Other (Describe) \_\_\_\_\_

GEOLOGIC DATA (Office Use Only)

Surface Elev.	Geologic Unit	Unit Thickness	Depth to Top
Subs. SWL	Date	Analysis	Aquifer Test

WELL GROUTED TO A DEPTH OF 10 FEET  
Type Grout (circle one): Cement, Bentonite, or Mix

SCREEN DATA

Diameter - Inches <u>3</u>	Length - Feet <u>40</u>	Slot Size - Inches <u>.008</u>
Screen Type <u>pvc</u>	Depth to Bottom - Feet <u>500</u>	

Driller's Remarks

Top of Lap Pipe or Reduction in Casing

FEET IF TELESCOPED OR MORE THAN ONE SCREEN: USE BACK PAGE

DESCRIPTION OF FORMATIONS ENCOUNTERED	FROM	TO

FORMATIONS CONTINUED FROM

TO

**RECEIVED**


OCT 05 1998

Dept. of Environmental Quality  
Office of Land & Water Resources

IF MORE SPACE IS NEEDED, USE BACK

If well telescopes please sketch and show depths.

GROUND LEVEL

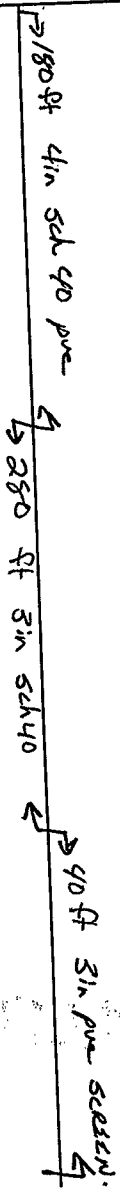


X			

SECTION 19

Please indicate well location X.

ADDITIONAL INFORMATION

Series of horizontal lines for additional information.

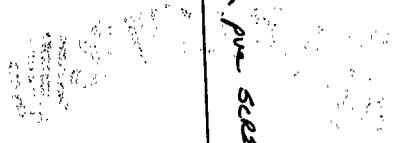

If more than one screen, show location of each on sketch.