

WASH.

MISSISSIPPI BOARD OF WATER COMMISSIONERS

B

BG

2-9-62

WATER WELL DRILLERS

CODED

Date: 2/9, 1962, Driller: Bailey Drilling Co. County: Washington (Name)

	Description & Color of Materials Sand, Clay, Red Clay, Shell, etc.	Thick- ness Feet	Depth Feet
(1) Owner of Land: <u>W.C. Dantzer</u> (Name) <u>Greenville, Miss.</u> (Address)	Clay Sand	28 37	28 65
(2) Location: <u>NW 1/4, SE 1/4, Sec. 9</u> T19 ^N R7 ^W <u>6</u> miles <u>N.W.</u> of <u>Leland</u> (distance) (direction) (Nearest Town)	Gravel + Sand Mud Sand	35 156 103	100 216 359
(3) Topography: <u>Flat</u> (Hilly) (Flat) (Level)	Mud + Sand Sand	41 55	400 455
(4) Purpose of Well: <u>Domestic</u> (Domestic Irrigation Municipal, Industrial, Other)			

CODED


Information upon completion of well:

- (1) Diameter 2 inches.
- (2) Total Depth 455 feet.
- (3) Water Level 28 feet below top of ground.
- (4) Cased to all way Size 2
- (5) Screen: Size 2, Length 10 ft
- (6) Were any formations sealed against pollution?
_____ yes, X no.

If YES depth of formation _____

Why _____

Drillers Remarks: _____

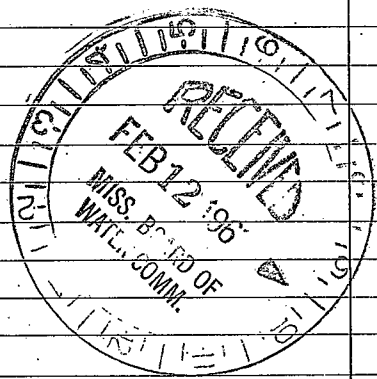

(Use Back Side)

Well No.

