

B7

6-10-58

WATER WELL DRILLERS LOG

CODED

10/11/65
2553

Date: June 10, 1958, Driller: Layne-Central Company County Washington

(Name)

- (1) Owner of Land: John T. Smith
(Name)
Cleveland, Mississippi
(Address)
- (2) Location: SE 1/4, SE 1/4, Sec. 12-19^N 7^W
Napanee Community
6 miles north of Greenville
(distance) (direction) (Nearest Town)
- (3) Topography: flat
(Hilly) (Flat) (Level)
- (4) Purpose of Well: irrigation
(Domestic Irrigation
Municipal, Industrial, Other)

Description & Color of Materials Sand, Clay, Red Clay, Shell, etc.	Thick- ness Feet	Depth Feet
Clay	15	15
Coarse brown sand	8	23
Fine blue sand	11	34
Coarse sand & pea rock	18	52
Coarse sand & lignite	20	72
Sand & gravel	20	92
Sand & gravel	10	102
Sand & big gravel	10	112

Information upon completion of well:

- (1) Diameter 12 inches.
- (2) Total Depth 112 feet.
- (3) Water Level 10'9" feet below top of ground.
- (4) Cased to 65', Size 12"
- (5) Screen: Size 12", Length 50'
- (6) Were any formations sealed against pollution?

CODED

no yes, no no.


If YES depth of formation _____

Why _____

Drillers Remarks: _____

1800 GPM.

Engine drive.

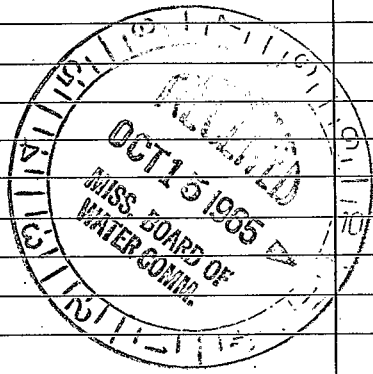

(Use Back Side)

Well No.

