

Washington

B9

MISSISSIPPI BOARD OF WATER COMMISSIONERS

1-67

WATER WELL DRILLERS LOG

DYER WELL

Washington

Date: 1-14, 1967, Driller: IRRIGATION SERVICE, County: LEFLORE

(1) Owner of Land: HARRISON RANCH (Name) GREENVILLE, MISS (Address)

(2) Location: NW 1/4, SE 1/4, Sec. 12 T19R7, 7 miles No of Beland (distance) (direction) (Nearest Town)

(3) Topography: FLAT (Hilly) (Flat) (Level)

(4) Purpose of Well: IRRIGATION (FISH) (Domestic Irrigation Municipal, Industrial, Other)

Table with 3 columns: Description & Color of Materials, Thickness Feet, Depth Feet. Rows include Clay, Fine Sand, Medium Sand, Coarse Green Sand, Coarse Sand & Red Rock, Medium Red Sand, Gravel.


Information upon completion of well:

- (1) Diameter 16 inches. (2) Total Depth 104 feet. (3) Water Level 16 feet below top of ground. (4) Cased to 64', Size 16". (5) Screen: Size 16", Length 40 Ft. (6) Were any formations sealed against pollution? yes, X no.

If YES depth of formation

Why

Drillers Remarks:

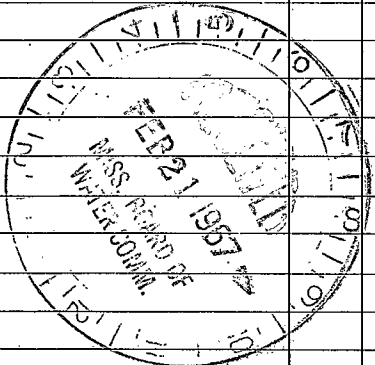

(Use Back Side)

Well No.

