

Washington
 B11
 2-68

MISSISSIPPI
 BOARD OF WATER COMMISSIONERS
 416 North State Street
 Jackson, Mississippi 39201

WATER WELL DRILLERS LOG

2-6 1968 DYER WELL & IRR. WASHINGTON
 date well completed firm name county well located

LANDOWNER: WESTON ABSHIRE
 R. Rte

GREENVILLE, MISS.
 (mailing address)


WELL LOCATION:
 sec. 15 T. 19 N. R. 7 E
 6 miles N of STONEDVILLE
 (distance) (direction) (nearest town)

WELL PURPOSE:
 (home, irrigation, municipal, industrial)

WELL COMPLETION DATA:

- (1) diameter (inches) 16"
- (2) total depth (feet) 107'
- (3) static water level (feet) 18' below top of ground.
- (4) casing PVC IR 67' (material) (depth)
 16" (size) if telescope see back.
- (5) screen 40' 67' (length) (depth to top)
 16" BLK. INBOT (size) (material)
- (6) pump 60 3000 (HP) (yield gpm)
 DIESEL (type power)
- (7) electric log NO (yes or no)
 (organization running log)
- (8) how well bottom plugged PLATE
 WELDED ON BOTTOM

description of formations encountered	from to	
CLAY	0	13
CLAY	13	23
FINE SAND	23	33
CLAY	33	43
MED. SAND	43	53
COARSE SAND	53	63
COARSE SAND & GRAVEL	63	107
CLAY	107	

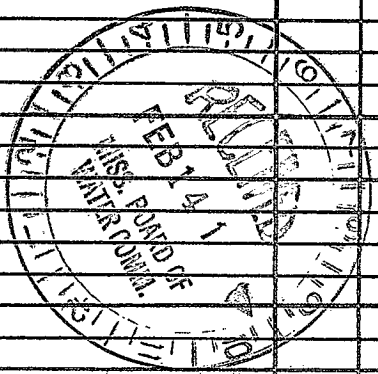

DRILLERS REMARKS:

If well telescopes please sketch and show depths.

GROUND LEVEL

X			

SECTION 15

Please indicate well location X.

ADDITIONAL INFORMATION

If more than one screen,
show locations of each on sketch.