

Washington
 B12
 2-68

MISSISSIPPI
 BOARD OF WATER COMMISSIONERS
 416 North State Street
 Jackson, Mississippi 39201

WATER WELL DRILLERS LOG

2-10 1968 Dyerwell LTR SWR Wash.
 date well completed firm name county well located

LANDOWNER: CAREY PRAETHE
 R. Rte

description of formations encountered	from	to
CLAY	0	13
FINE SAND	13	23
MED. SAND	23	33
FINE SAND	33	43
COARSE SAND	43	53
✓ ✓	53	63
✓ ✓	63	73
C. SAND & GRAVEL	73	108

LELAND, MISS.
 (mailing address)


WELL LOCATION:
 sec. 33 T. 19 N. R. 7 E
 5 miles No of ELIZABETH
 (distance) (direction) (nearest town)

WELL PURPOSE: IRRIGATION
 (home, irrigation, municipal, industrial)

WELL COMPLETION DATA:


- (1) diameter (inches) 16"
- (2) total depth (feet) 108'
- (3) static water level (feet) 18' below top of ground.
- (4) casing ^{2 1/2"} IRON, 68' (material), (depth)
- _____ if telescope see back.
 (size)
- (5) screen 40' 68' (length), (depth to top)
 16" BRK. INGOT (size), (material)
- (6) pump 50 2500 (HP), (yield gpm)
 DIESEL (type power)
- (7) electric log NO (yes or no)
- (organization running log)
- (8) how well bottom plugged PLATE ON BOTTOM

DRILLERS REMARKS:

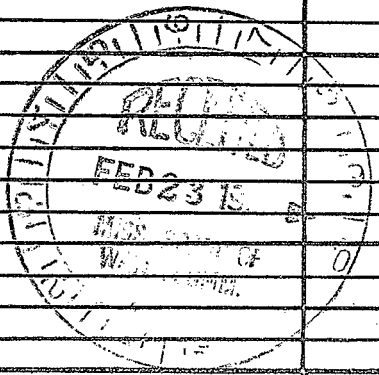

If well telescopes please sketch and show depths.

GROUND LEVEL

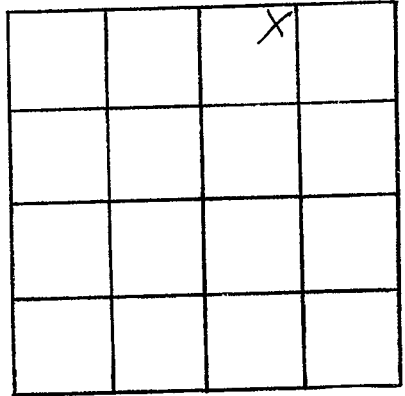

SECTION 23

Please indicate well location X.

ADDITIONAL INFORMATION

If more than one screen,
show locations of each on sketch.