

WASH.
B13
5-2-62

MISSISSIPPI BOARD OF WATER COMMISSIONERS

WATER WELL DRILLERS LOG

5/17/62
288

Date: May 2, 19 62, Driller: Layne-Central Company County Washington

(Name)

	Description & Color of Materials Sand, Clay, Red Clay, Shell, etc.	Thick- ness Feet	Depth Feet
(1) Owner of Land: <u>L. R. Flinn, Jr.</u> (Name) <u>Greenville, Mississippi</u> (Address)	Clay	44	44
(2) Location: <u>1/4</u> , <u>1/4</u> , Sec. <u>19</u> T <u>R 7W</u> <u>Greenville</u> <u>19N</u> <u>miles east</u> , of <u>Air Base</u> (distance) (direction) (Nearest Town)	Clay balls & sand	4	48
	Coarse sand	24	72
	Coarse sand & pea gravel	23	95
	Clay		95
(3) Topography: <u>flat</u> (Hilly) (Flat) (Level)			
(4) Purpose of Well: <u>Irrigation</u> (Domestic Irrigation Municipal, Industrial, Other)			


Information upon completion of well:

- (1) Diameter 12 inches.
- (2) Total Depth 95 feet.
- (3) Water Level 4' - 8" feet below top of ground.
- (4) Cased to 55', Size 12".
- (5) Screen: Size 12", Length 40'.
- (6) Were any formations sealed against pollution?
no yes, no no.

If YES depth of formation _____

Why _____

Drillers Remarks: _____

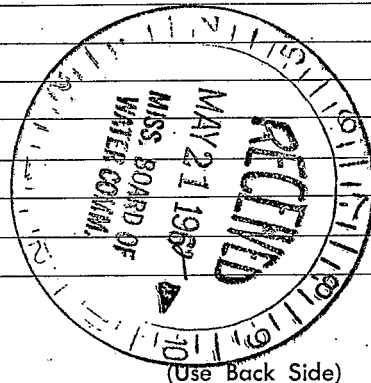

Well No.

