

Washington
B 017
3-66

MISSISSIPPI BOARD OF WATER COMMISSIONERS

CODED

WATER WELL DRILLERS LOG

Date: 3-11, 1966, Driller: Butane Gas Co. of Greenwood County Wash ~~Leflore~~

(Name)

(1) Owner of Land: Rex Morgan
(Name)
Leland, Miss.
(Address)

(2) Location: SE 1/4, NE 1/4, Sec 19 14N 7W
7 miles N.W. of Leland
(distance) (direction) (Nearest Town)

(3) Topography: Flat
(Hilly) (Flat) (Level)

(4) Purpose of Well: Irrigation
(Domestic Irrigation
Municipal, Industrial, Other)

Description & Color of Materials Sand, Clay, Red Clay, Shell, etc.	Thick- ness Feet	Depth Feet
Clay	13	13
Clay	10	23
Clay	10	33
Sand and Gravel	10	43
Sand and Gravel	10	53
Sand and Gravel	10	63
Sand and Gravel	10	73
Sand and Gravel	10	83
Sand and Gravel	10	93

Information upon completion of well:

(1) Diameter 16 inches.

(2) Total Depth 90 feet.

(3) Water Level 20 feet below top of ground.

(4) Cased to 50, Size 16

(5) Screen: Size 16, Length 40


(6) Were any formations sealed against pollution?
no yes, X no.

Insuff. info. to locate

If YES depth of formation _____

Why _____

Drillers Remarks: _____

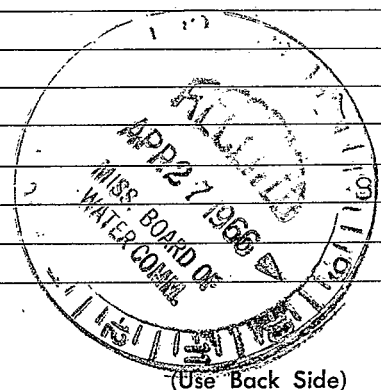

(Use Back Side)

Well No.

100