

~~A B 18~~

CODED

WATER WELL DRILLERS LOG

7-11-63

Date: 7/11, 1963, Driller: Bailey Drly Co County Washington  
(Name)

(1) Owner of Land:	Description & Color of Materials	Thick-ness Feet	Depth Feet
<u>Rt. Denmark</u> (Name) <u>Greenville</u> (Address)	<u>Clay</u>		<u>12</u>
(2) Location: <u>1/4</u> , <u>1/4</u> , Sec. <u>30</u> <u>15 N 9 W</u> T. R. <u></u> <u>4</u> miles <u>NE</u> of <u>Greenville</u> (distance) (direction) (Nearest Town)	<u>Sand</u>		<u>72</u>
(3) Topography: <u>Flat</u> (Hilly) (Flat) (Level)	<u>Gravel</u>		<u>100</u>
(4) Purpose of Well: <u>Domestic</u> (Domestic Irrigation Municipal, Industrial, Other)	<u>Mud</u>		<u>410</u>
	<u>Fine sand</u>		<u>460</u>
	<u>Medium sand</u>		<u>493</u>

Information upon completion of well:

(1) Diameter 3 X 2 inches.


(2) Total Depth 493 feet.

(3) Water Level 54 feet below top of ground.

(4) Cased to all way Size 3 X 2.

(5) Screen: Size 2", Length 10ft.

(6) Were any formations sealed against pollution?  
\_\_\_\_\_ yes, X no.

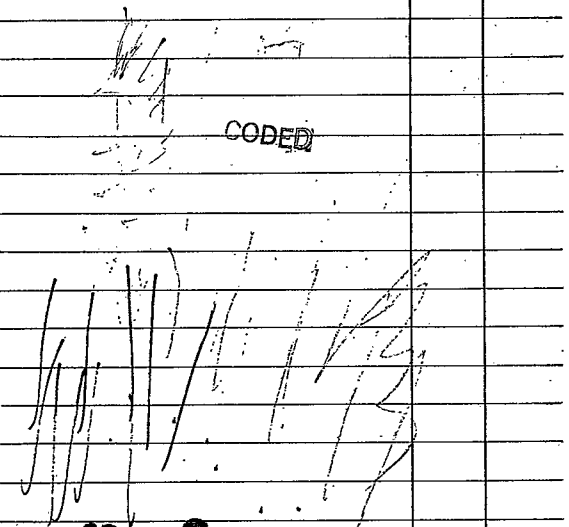


CODED

Drill. info to locate

If YES depth of formation \_\_\_\_\_

Why \_\_\_\_\_

Drillers Remarks: \_\_\_\_\_

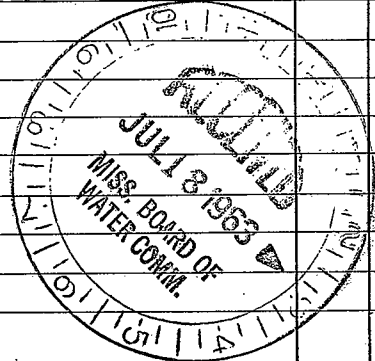

(Use Back Side)

Well No.

[The page contains extremely faint and illegible text, likely bleed-through from the reverse side of the document. No specific words or phrases can be discerned.]