

WASHINGTON
 B 19
 2-27-69

MISSISSIPPI
 BOARD OF WATER COMMISSIONERS
 416 North State Street
 Jackson, Mississippi 39201

3/17/69
 Jm
 C2821
 Well #1

WATER WELL DRILLERS LOG

February 27, 1969 Layne-Central Company Washington
 date well completed firm name county well located

| LANDOWNER: <u>Verl Fullen</u> | description of formations encountered | from | to |
|--|---------------------------------------|------|-----|
| | | | |
| | Coarse sand, pea gravel | 35 | 104 |
| <u>Shaw, Mississippi</u> (mailing address) | Big boulders | 104 | 108 |
| | Clay | | 108 |
| WELL LOCATION: | | | |
| sec <u>7.8</u> T <u>19N</u> N R <u>7</u> W E W | | | |
| <u>2</u> miles <u>east</u> of <u>Priscilla</u> (distance) (direction) (nearest town) | | | |
| WELL PURPOSE: <u>irrigation</u> (home, irrigation, municipal, industrial) | | | |
| WELL COMPLETION DATA: | | | |
| (1) diameter (inches) <u>16</u> | | | |
| (2) total depth (feet) <u>108</u> | | | |
| (3) static water level (feet) <u>11</u> <u>below</u> top of ground. above | | | |
| (4) casing <u>steel</u> <u>58'</u> (material) (depth) <u>16"</u> (size) if telescope see back. | | | |
| (5) screen <u>50'</u> <u>108'</u> (length) (depth to top) <u>16"</u> <u>Armco</u> (size) (material) | | | |
| (6) pump <u>50</u> <u>2400</u> (HP) (yield gpm) <u>electric</u> (type power) | | | |
| (7) electric log <u>no</u> (yes or no) | | | |
| <u>(organization running log)</u> | | | |
| (8) how well bottom plugged <u>plate</u> | | | |
| DRILLERS REMARKS: | | | |

VOID


VOID

MAR 19 1969

MISS. DE. OF
 WATER CONTROL

If well telescopes please sketch and show depths.

GROUND LEVEL

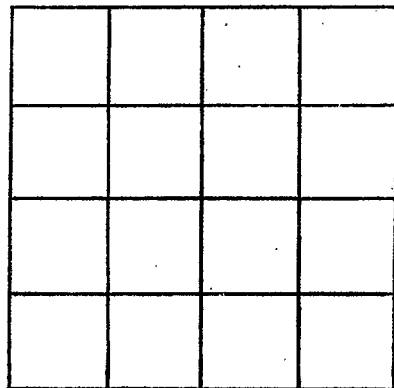

SECTION _____

Please indicate well location X.

ADDITIONAL INFORMATION

If more than one screen, show locations of each on sketch.