

WASHINGTON  
 B 20  
 3-4-69

MISSISSIPPI  
 BOARD OF WATER COMMISSIONERS  
 416 North State Street  
 Jackson, Mississippi 39201

3/17/69  
 Jm

WATER WELL DRILLERS LOG

C2821  
 Well #2

COPIED

March 4, 1969 Layne-Central Company Washington  
 date well completed firm name county well located


LANDOWNER: Verl Fullen	description of formations encountered	from	to
Shaw, Mississippi (mailing address)			
WELL LOCATION: sec. 8 T. 19 N R. 7 E xX xX Priscilla (distance) (direction) (nearest town)	Coarse sand, pea gravel	30	95
WELL PURPOSE: Irrigation (home, irrigation, municipal, industrial)	Rock		95
WELL COMPLETION DATA: (1) diameter (inches) 16			
(2) total depth (feet) 95 below			
(3) static water level (feet) 11 above			
(4) casing steel 45' (material) (depth) 16" if telescope see back. (size)			
(5) screen 50' 95' (length) (depth to top) 16" Armco (size) (material)			
(6) pump 40 2400 (HP) (yield gpm) electric (type power)			
(7) electric log no. (yes or no) (organization running log)			
(8) how well bottom plugged plate			
DRILLERS REMARKS:			

MAR 19 1969

MISS. Bd. of  
 WATER CONTROL

If well telescopes please  
sketch and show depths.

GROUND LEVEL

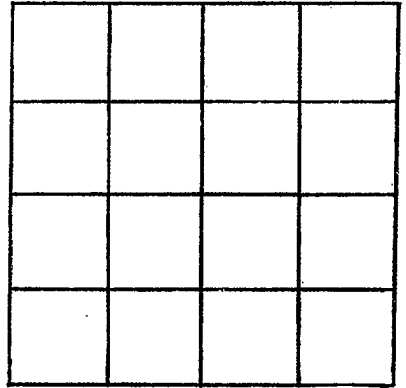

SECTION \_\_\_\_\_

Please indicate well location X.

ADDITIONAL INFORMATION

If more than one screen,  
show locations of each on sketch.