

WASHINGTON
 B 21
 3-6-69

MISSISSIPPI
 BOARD OF WATER COMMISSIONERS
 416 North State Street
 Jackson, Mississippi 39201
 WATER WELL DRILLERS LOG

3/17/69
[Signature]
 Well #3
 C2821

March 6, 1969 Lavne-Central Company Washington
 date well completed firm name county well located


LANDOWNER:	description of formations encountered	from	to
Verl. Fullen	Clay	0	30
Shaw, Mississippi	Coarse sand, pea gravel	30	95
(mailing address)	Big Boulders	95	102
	Clay		102
WELL LOCATION:			
sec. 8 T19 N R7 EX W			
Priscilla			
(distance) miles (direction) of (nearest town)			
WELL PURPOSE: irrigation			
(home, irrigation, municipal, industrial)			
WELL COMPLETION DATA:			
(1) diameter (inches) 16			
(2) total depth (feet) 102 below			
(3) static water level (feet) 10 above top of ground			
(4) casing steel, 52' (material) (depth)			
16" (size) if telescope see back.			
(5) screen 50' (length), 102' (depth to top)			
16" (size), Armco (material)			
(6) pump 40 (HP), 2400 (yield gpm)			
electric (type power)			
(7) electric log no (yes or no)			
(organization running log)			
(8) how well bottom plugged plate			

DRILLERS REMARKS:

APR 10 1969
 MISSISSIPPI BOARD OF WATER COMMISSIONERS
 JACKSON, MISSISSIPPI

If well telescopes please
sketch and show depths.

GROUND LEVEL

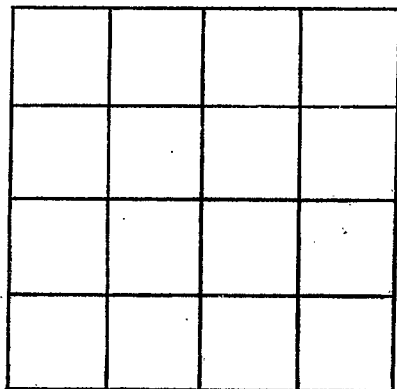

SECTION _____

Please indicate well location X.

ADDITIONAL INFORMATION

If more than one screen,
show locations of each on sketch.