

WASHINGTON
B23
8-24-70

MISSISSIPPI
BOARD OF WATER COMMISSIONERS
416 North State Street
Jackson, Mississippi 39201

CODED

WATER WELL/DRILLERS LOG

Aug 24 1970 Schultz Drilling Co Washington
date well/completed firm name county well located

LANDOWNER: Walter Clark

description of formations encountered

from to

Peland, Miss
(mailing address)

Clay 0 23

Sand 23 99

WELL LOCATION:

sec. 28 T 19 N R 7 W
miles of (distance) (direction) (nearest town)

Clay 99 202

Sandy Shale 202 222

WELL PURPOSE: Home
(home, irrigation, municipal, industrial)

Clay 222 344

Sandy Shale 344 375

WELL COMPLETION DATA:

- (1) diameter (inches) 4 x 2
- (2) total depth (feet) 482
- (3) static water level (feet) 23 below top of ground.
- (4) casing (material) (depth)

Sand 375 385

Clay Blue 385 388

Sand 388 485

yes (size) if telescope see back.

- (5) screen 20 (length) (depth to top)
2" (size) 5/16" (material)

- (6) pump 1 (HP) 30 (yield gpm)

Ele (type power)

- (7) electric log NO (yes or no)

(organization running log)

- (8) how well bottom plugged Wash

CODED


SEP 17 1970

DRILLERS REMARKS:

MISS. Bd. OF
WATER COMMISSIONERS

If well telescopes please sketch and show depths.

GROUND LEVEL

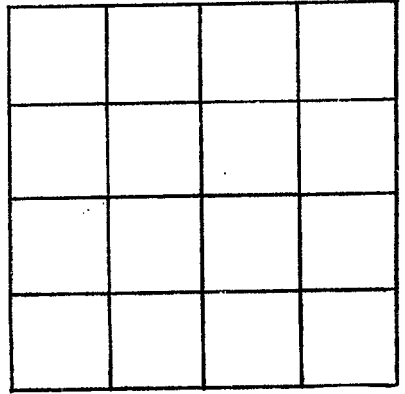

SECTION _____

Please indicate well location X.

ADDITIONAL INFORMATION

If more than one screen, show locations of each on sketch.