

Washington
 B 24
 4-13-70

MISSISSIPPI
 BOARD OF WATER COMMISSIONERS
 416 North State Street
 Jackson, Mississippi 39201

6/26/70
 Jm

WATER WELL DRILLERS LOG

CODED

C3134

April 13, 1970 Layne-Central Company Washington
 date well completed firm name county well located

LANDOWNER: R. C. Mouton Shaw, Mississippi (mailing address)	description of formations encountered	from	to
		Clay	0
	Coarse sand	30	40
	Coarse sand, gravel	40	80
	Sand & boulders]	80	112

WELL LOCATION:
 sec. 10 T 19 N R 7 W
 4 miles west of Helm
 (distance) (direction) (nearest town)

WELL PURPOSE: irrigation
 (home, irrigation, municipal, industrial)

- WELL COMPLETION DATA:
- (1) diameter (inches) 16
 - (2) total depth (feet) 112
 - (3) static water level (feet) 20' below top of ground.
 - (4) casing steel, 62' (material), (depth)
 16" (size) if telescope see back.
 - (5) screen 50' 112' (length), (depth to top)
 16" (size), Armco (material)
 - (6) pump 50 (HP) 2400 (yield gpm)
 engine (type/power)
 - (7) electric log no (yes or no)
 (organization running log)
 - (8) how well bottom plugged plate


CODED

JUL 8 1970

DRILLERS REMARKS:

If well telescopes please
sketch and show depths.

GROUND LEVEL

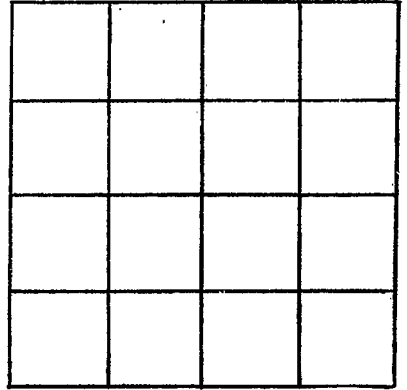

SECTION _____

Please indicate well location X.

ADDITIONAL INFORMATION

If more than one screen,
show locations of each on sketch.