

**CODED**

MISSISSIPPI  
BOARD OF WATER COMMISSIONERS  
416 North State Street  
Jackson, Mississippi 39201

WASHINGTON  
B 25  
1-19-73

WATER WELL DRILLERS LOG

1/19 1973 date well completed  
Bailey Drilling Co firm name  
Washington county well located

LANDOWNER: U.S. Government  
Stoneville  
Miss.  
(mailing address)

description of formations encountered	from	to
	Clay	0
Sand	15	88
Gravel	88	98

WELL LOCATION:  
sec. 29 T. 19 N. R. 7  
at Stoneville  
(distance) (direction) (nearest town)

WELL PURPOSE: Greenhouse Headhouse  
(home, irrigation, municipal, industrial)


- WELL COMPLETION DATA:
- (1) diameter (inches) 2"
  - (2) total depth (feet) 98
  - (3) static water level (feet) 19 below top of ground.
  - (4) casing steel, 93  
(material) (depth)  
2" If telescope see back.  
(size)
  - (5) screen 5', 93  
(length) (depth to top)  
2", Stainless Steel  
(size) (material)
  - (6) pump 1, 10  
(HP) (yield gpm)  
Electric  
(type power)
  - (7) electric log No  
(yes or no)
- (organization running log)
- (8) how well bottom plugged  
Back pressure valve

DRILLERS REMARKS:

JAN 20 1973

If well telescopes please  
sketch and show depths.

GROUND LEVEL

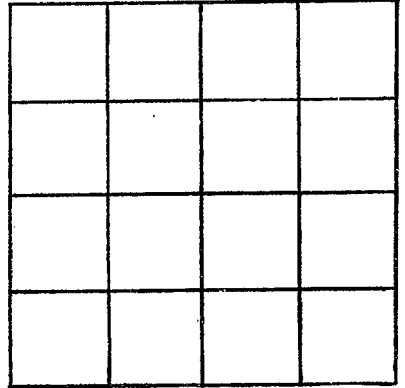

SECTION \_\_\_\_\_

Please indicate well location X.

ADDITIONAL INFORMATION

If more than one screen,  
show locations of each on sketch.