

WASHINGTON

B 26

2-18-73

MISSISSIPPI BOARD OF WATER COMMISSIONERS
416 North State Street
Jackson, Mississippi 39201

CODED

WATER WELL DRILLERS LOG

485-6 73

Lambert Drilling Co.

Wash.

date well completed

firm name

county well located

LANDOWNER:

City of Leland.

Leland Miss.

(mailing address)

description of formations encountered

from

to

Clay

0

18

Sand.

18

65

Sand & gravel

65

94

Clay

94

110

WELL LOCATION:

sec. 3 T. 19 N R. 7 E
S W

2 1/2 miles NW of Leland
(distance) (direction) (nearest town)

WELL PURPOSE: industrial
(home, irrigation, municipal, industrial)

WELL COMPLETION DATA:

- (1) diameter (inches) 4"
- (2) total depth (feet) 94'
- (3) static water level (feet) 12' below top of ground.
- (4) casing galv. 84' (material) (depth)

(size) if telescope see back.

- (5) screen 10' 94-84' (length) (depth to top)
- 3" S.S. (size) (material)

- (6) pump 1 20 (HP) (yield gpm)
- Elect (type power)

- (7) electric log (yes or no)

(organization running log)

- (8) how well bottom plugged backwash

CODED

DRILLERS REMARKS:

If well telescopes please sketch and show depths.


GROUND LEVEL

84

4"

10' ss.
94'

3" screen

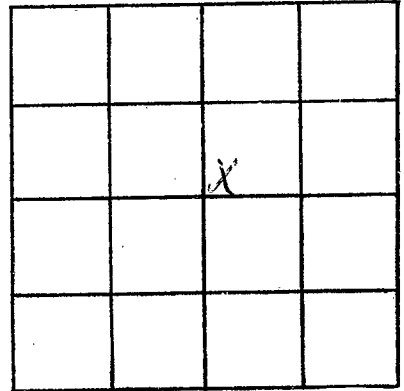

SECTION 3

Please indicate well location X.

ADDITIONAL INFORMATION

Sand to 94 ft

blue clay 94 to 110

If more than one screen, show locations of each on sketch.