

B 27
 WASHINGTON
 6-11-73

MISSISSIPPI
 BOARD OF WATER COMMISSIONERS
 416 North State Street
 Jackson, Mississippi 39201

WATER WELL DRILLERS LOG

CODED

6/11 1973 Schultz Drilling Co Washington
 date well completed firm name county well located

LANDOWNER: Henry Beck description of formations encountered from to
Shreveville, Miss clay 0 16
 (mailing address) sand 16 20

WELL LOCATION:
 sec. 18 T. 19 N R. 7 E
 6 miles NE of And
 (distance) (direction) (nearest town)

CODED


WELL PURPOSE: Home
 (home, irrigation, municipal, industrial)

- WELL COMPLETION DATA:
- (1) diameter (inches) 2"
 - (2) total depth (feet) 65
 - (3) static water level (feet) 17 below above top of ground.
 - (4) casing P.V.C. (material) (depth)
 (size) if telescope see back.
 - (5) screen 5 (length) (depth to top)
2" (size) P.V.C. (material)
 - (6) pump (HP) (yield gpm)
 (type power)
 - (7) electric log (yes or no)
 (organization running log)
 - (8) how well bottom plugged Plug

DRILLERS REMARKS: AUG 28 1973

If well telescopes please sketch and show depths.

GROUND LEVEL

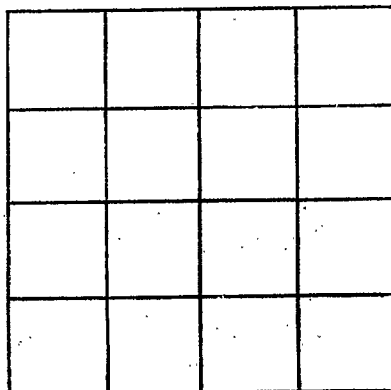

SECTION _____

Please indicate well location X.

ADDITIONAL INFORMATION

If more than one screen,
show locations of each on sketch.