

WASHINGTON
B29
3-14-75

MISSISSIPPI
BOARD OF WATER COMMISSIONERS
416 North State Street
Jackson, Mississippi 39201

WATER WELL DRILLERS LOG

CODED

3-14-75
date well completed

EUTANE GAS CO. OF GREENWOOD
firm name

WASHINGTON
county well located

LANDOWNER:
Steve FRATESI
Leland,
(mailing address)

description of formations encountered	from	to
Clay	0	20
Fine Sand	20	40
Sand & Pea Gravel	40	60
Sand & Gravel	60	80
GRAVEL	80	100

WELL LOCATION:
sec. 36 T. 19 N R. 7 E
3 miles N of ELIZABETH
(distance) (direction) (nearest town)

WELL PURPOSE: DR
(home, irrigation, municipal, industrial)

CODED

WELL COMPLETION DATA:

- (1) diameter (inches) 16"
- (2) total depth (feet) 100
- (3) static water level (feet) 17 below above top of ground.
- (4) casing Steel 60
(material) (depth)
16" if telescope see back.
(size)
- (5) screen 40 60
(length) (depth to top)
- 16"
(size) Steel
(material)
- (6) pump 60 2500
(HP) (yield gpm)
Diesel
(type power)
- (7) electric log No
(yes or no)

(organization running log)

(8) how well bottom plugged
Steel plate


RECEIVED
MAR 24 1975

DRILLERS REMARKS:

MISS. BD. OF WATER COMMISSIONERS

If well telescopes please sketch and show depths.

GROUND LEVEL

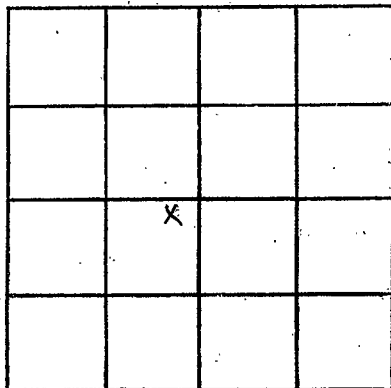

SECTION 36

Please indicate well location X.

ADDITIONAL INFORMATION

If more than one screen, show locations of each on sketch.