

Washington
 B 38
 5-13-80 2/18/80

MISSISSIPPI
 BOARD OF WATER COMMISSIONERS
 416 North State Street
 Jackson, Mississippi 39201
 WATER WELL DRILLERS LOG

CODED

Feb 18 1980 Larry's Well + Pump Washington
 date well completed firm name county well located

LANDOWNER: John Barnett
 Greenville, MS
 (mailing address)

description of formations encountered	from	to
Clay	0'	20'
fine sand	20'	35'
Coarse sand	35'	60'
Coarse sand + sm gravel	60'	110'

WELL LOCATION:
 sec. 9 T 19(N) S R 7 E W
 7 miles N of Leland
 (distance) (direction) (nearest town)

WELL PURPOSE:
 (home, irrigation, municipal, industrial)

WELL COMPLETION DATA:

(1) diameter (inches) 16"

(2) total depth (feet) 110'

(3) static water level (feet) 19' ^{below} above top of ground.

(4) casing Steel 70'
 (material) (depth)

(size) If telescope see back.

(5) screen 40' 70'
 (length) (depth to top)

16" Steel
 (size) (material)

(6) pump 60 3000
 (HP) (yield gpm)

(type power)

(7) electric log No
 (yes or no)

(organization running log)

(8) how well bottom plugged
 Steel plate

DRILLERS REMARKS:

CODED


DEPT. OF NATURAL RESOURCES
 BUREAU OF LAND & WATER RESOURCES

MAY 18 1980

RECEIVED

If well telescopes please sketch and show depths.

GROUND LEVEL

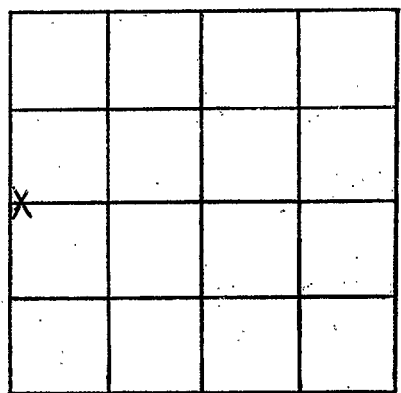

SECTION 9

Please indicate well location X.

ADDITIONAL INFORMATION

Lined area for additional information.

If more than one screen, show locations of each on sketch.