

MISSISSIPPI DEPARTMENT OF NATURAL RESOURCES

Bureau of Land and Water Resources

Southport Mall

P.O. Box 10631

Jackson, Mississippi 39209
WATER WELL DRILLERS LOG

CODED

Washington
B 39
5/29/82

5-29 1982
date well completed

BUTANE GAS COMPANY
OF GREENWOOD

Washington
county well located

LANDOWNER:	description of formations encountered	from	to
Stoneville	Clay	0	20
Leland Mo. (mailing address)	Sand & Sand and Gravel	20 40	40 103
WELL LOCATION: sec. 35 T 19 N R 7 W 2.5 miles N of Elzebeth (distance) (direction) (nearest town)			
WELL PURPOSE: <u>Municipal</u> (home, irrigation, municipal, industrial)			
WELL COMPLETION DATA:			
(1) diameter (inches) <u>16"</u>			
(2) total depth (feet) <u>103</u>			
(3) static water level (feet) <u>15</u> ^{below} / _{above} top of ground.			
(4) casing <u>Steel, 63'</u> (material) (depth)			
<u>16"</u> if telescope see back. (size)			
(5) screen <u>40, 63'</u> (length) (depth to top)			
<u>16"</u> , <u>Steel</u> (size) (material)			
(6) pump <u>60</u> <u>1700</u> (HP) (yield gpm)			
<u>Diesel</u> (type power)			
(7) electric log <u>No</u> (yes or no)			
<u>No</u> (organization running log)			
(8) how well bottom plugged <u>Steel plate</u>			
DRILLERS REMARKS: <u>Carlos Ramos</u>			

CODED


DEPT. OF NATURAL RESOURCES
BUREAU OF LAND & WATER RESOURCES

JUN 17 1982

RECEIVED

If well telescopes please sketch and show depths.

GROUND LEVEL

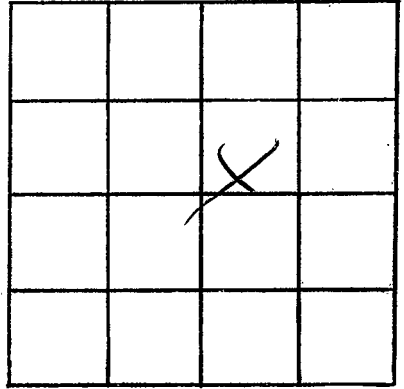

SECTION 35

Please indicate well location X.

ADDITIONAL INFORMATION

If more than one screen,
show locations of each on sketch.