

Washington  
 CL-1939 B40  
 717181

MISSISSIPPI  
 BOARD OF WATER COMMISSIONERS  
 416 North State Street  
 Jackson, Mississippi 39201

43

WATER WELL DRILLERS LOG

CODED

7-7 1981 LAYNE-CENTRAL CO. WASHINGTON  
 date well completed firm name county well located

LANDOWNER:  
 STONEVILLE PEDIGREED SEED  
 STONEVILLE, MS  
 (mailing address)

WELL LOCATION:  
 sec. 32 T. 19 N R. 7 W  
 2 miles N of Stoneville  
 (distance) (direction) (nearest town)

description of formations encountered	from	to
clay	0	19
fine sand	19	22
fine sand	22	32
coarse sand & pea gravel	32	62
" " " "	62	82
coarse sand & gravel	82	112

WELL PURPOSE: irrigation  
 (home, irrigation, municipal, industrial)

WELL COMPLETION DATA:

(1) diameter (inches) 28"

(2) total depth (feet) 112'

(3) static water level (feet) 20' 7" below top of ground.

(4) casing steel 72' (material) (depth)  
 12" (size) if telescope see back.

(5) screen 40' 72' (length) (depth to top)  
 12" st. steel (material)

(6) pump 60 1800 (HP) (yield gpm)  
 Diesel (type power)

(7) electric log no (yes or no)

(organization running log)

(8) how well bottom plugged st.plate

DRILLERS REMARKS:

CODED


DEPT. OF NATURAL RESOURCES  
 BUREAU OF LAND & WATER RESOURCES

JUN 24 1982

RECEIVED

If well telescopes please sketch and show depths.

GROUND LEVEL

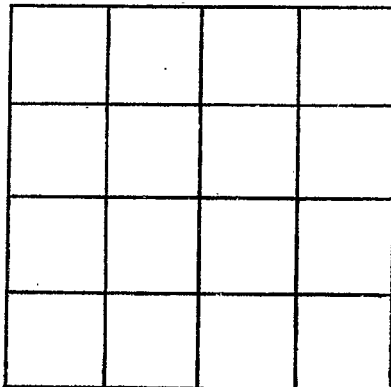

SECTION \_\_\_\_\_

Please indicate well location X.

ADDITIONAL INFORMATION

A series of horizontal lines for entering additional information.

If more than one screen, show locations of each on sketch.