

B 42
 WASHINGTON
 7-20-83

MISSISSIPPI
 BOARD OF WATER COMMISSIONERS
 416 North State Street
 Jackson, Mississippi 39201

CODED


WATER WELL DRILLERS LOG

7-20 1983 Schultz Drilling Washington
 date well completed firm name county well located

LANDOWNER:	description of formations encountered	from	to
Walker Farms Stoneville MS (mailing address)			
WELL LOCATION: sec. 32 T. 19 N. R. 7 E 3 miles W of Stoneville (distance) (direction) (nearest town)			
WELL PURPOSE: (home, irrigation, municipal, industrial)			
WELL COMPLETION DATA:			
(1) diameter (inches) 16"			
(2) total depth (feet) 96'			
(3) static water level (feet) 21' below top of ground.			
(4) casing PVC 56' (material) (depth)			
(size) If telescope see back.			
(5) screen 40' 56' (length) (depth to top)			
16" PVC (size) (material)			
(6) pump 40 1500 (HP) (yield gpm)			
ele (type power)			
(7) electric log No (yes or no)			
X (organization running log)			
(8) how well bottom plugged cap			
DRILLERS REMARKS:			

If well telescopes please sketch and show depths.

GROUND LEVEL

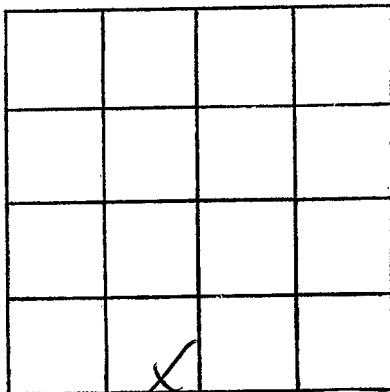

SECTION 32

Please indicate well location X.

ADDITIONAL INFORMATION

If more than one screen,
show locations of each on sketch.