

MISSISSIPPI DEPARTMENT OF NATURAL RESOURCES

Bureau of Land and Water Resources

Southport Mall

P.O. Box 10631

Jackson, Mississippi 39209

WATER WELL DRILLERS LOG

CODED

WASHINGTON

B 43

March 25 1984  
date well completed

Larry's Well's Pump  
firm name

Washington  
county well located

LANDOWNER: Ralph Owens

description of formations encountered

from

to

Greenville, Ms.  
(mailing address)

slay	0	20
Fine Sand	20	40
coarse Sand/gravel	40	92

WELL LOCATION:

sec. 19 T 19 N R 7 E  
S W  
4 miles NE of Greenville  
(distance) (direction) (nearest town)

WELL PURPOSE:

(home, irrigation, municipal, industrial)

WELL COMPLETION DATA:

CODED

- (1) diameter (inches) 16"
- (2) total depth (feet) 92'
- (3) static water level (feet) 20 <sup>below</sup>/<sub>above</sub> top of ground.
- (4) casing steel 52'  
(material) (depth)  
(size) if telescope see back.
- (5) screen 40' 52'  
(length) (depth to top)  
16" Steel  
(size) (material)
- (6) pump 60 1500  
(HP) (yield gpm)  
(type power)
- (7) electric log NO  
(yes or no)  
(organization running log)

(8) how well bottom plugged Steel Plate

DRILLERS REMARKS:


DEPT. OF NATURAL RESOURCES  
BUREAU OF LAND & WATER RESOURCES

AUG 28 1984

RECEIVED

If well telescopes please sketch and show depths.

GROUND LEVEL

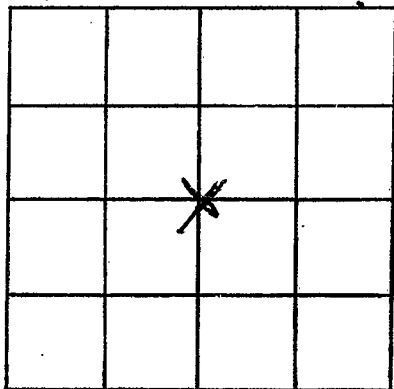

SECTION 19

Please indicate well location X.

ADDITIONAL INFORMATION

If more than one screen,  
show locations of each on sketch.