

WASHINGTON
CL-2785
B44

MISSISSIPPI DEPARTMENT OF NATURAL RESOURCES
 Bureau of Land and Water Resources
 Southport Mall
 P.O. Box 10631
 Jackson, Mississippi 39209
WATER WELL DRILLERS LOG

CODED

6/22 19 84 LAYNE-CENTRAL CO. WASHINGTON
 date well completed firm name county well located

LANDOWNER:
 DELTA BRANCH EXPERIMENT STA.
 STONEVILLE, MS
 (mailing address)

description of formations encountered	from	to
	clay	0
fine sand	12	60
coarse sand/pea gravel	60	110

WELL LOCATION:
 sec. 33 T 19 N R 7 E
 S W
 2 miles North of Stoneville
 (distance) (direction) (nearest town)

CODED

WELL PURPOSE: irrigation
 (home, irrigation, municipal, industrial)

- WELL COMPLETION DATA:**
- (1) diameter (inches) 7-7/8"
 - (2) total depth (feet) 110'
 - (3) static water level (feet) 14' below top of ground.
 - (4) casing PVC 90'
 (material) (depth)
4" if telescope see back.
 (size)
 - (5) screen 20' 90'
 (length) (depth to top)
4" PVC
 (size) (material)
 - (6) pump 1-1/2 50
 (HP) (yield gpm)
electric
 (type power)
 - (7) electric log n/a
 (yes or no)
(organization running log)
 - (8) how well bottom plugged PVC cap

DEPT. OF NATURAL RESOURCES
 BUREAU OF LAND & WATER RESOURCES


OCT 29 1984

RECEIVED

DRILLERS REMARKS:

If well telescopes please sketch and show depths.

GROUND LEVEL

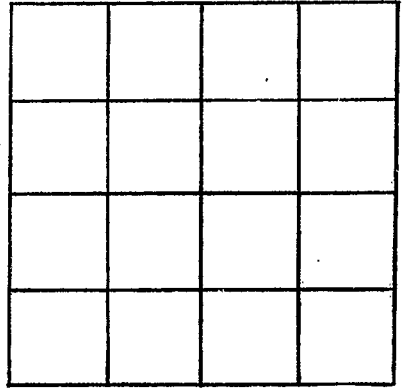

SECTION _____

Please indicate well location X.

ADDITIONAL INFORMATION

If more than one screen,
show locations of each on sketch.