

MISSISSIPPI DEPARTMENT OF NATURAL RESOURCES

Bureau of Land and Water Resources

Southport Mall

P.O. Box 10631

Jackson, Mississippi 39209

WATER WELL DRILLERS LOG

CODED

B45
 Washington
 10-9-85

10-9-85 19 Irrigation Equipment Washington
 date well completed firm name county well located

LANDOWNER: ALHAN FORD
1189 Old Leland Road
Greenville, MS 38701
 (mailing address)

description of formations encountered	depth	
	from	to
CLAY	0	55
FINE SAND	55	70
COARSE SAND/pea gravel	70	115

WELL LOCATION:
 sec 6 T 19 N R 7 E
11 miles NORTH of Greenville
 (distance) (direction) (nearest town)

CODED

WELL PURPOSE: Fish Pond
 (home, irrigation, municipal, industrial)

WELL COMPLETION DATA:

(1) diameter (inches) 16"
 (2) total depth (feet) 115
 (3) static water level (feet) 18 below above top of ground.
 (4) casing PVC 75'
 (material) (depth)
 (size) if telescope see back.
 (5) screen 40' 75'
 (length) (depth to top)
16" PVC
 (size) (material)
 (6) pump 40 2100
 (HP) (yield gpm)
Diesel
 (type power)
 (7) electric log NO
 (yes or no)
 (organization running log)
 (8) how well bottom plugged pvc bottom

RECEIVED
 OCT 16 1985


DRILLERS REMARKS:

Department of Natural Resources
 Bureau of Land & Water Resources

If well telescopes please sketch and show depths.

IRRIGATION EQUIPMENT
601/887-2555
INDIANOLA, MS

GROUND LEVEL

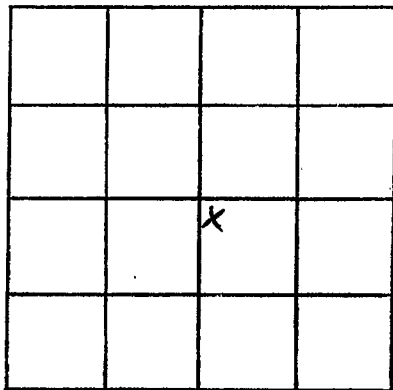

SECTION 6e

Please indicate well location X.

ADDITIONAL INFORMATION

If more than one screen,
show locations of each on sketch.