

MISSISSIPPI DEPARTMENT OF NATURAL RESOURCES

Bureau of Land and Water Resources

Southport Mall

P.O. Box 10631

Jackson, Mississippi 39209

WATER WELL DRILLERS LOG

CODED

WASHINGTON
 B 46
 MS-GW 2781

3-7-86
 date well completed

Roy's Pump
 firm name

WASHINGTON
 county well located

LANDOWNER: Percy BARONET

100 Peninsula Dr.
 Leland, Miss. 38756
 2nd WELL (mailing address)

description of formations encountered

from to

CLAY	0	30
FINE SAND	30	45
COARSE SAND/PEA GRAVEL	45	95

WELL LOCATION:

sec. 25 T 19 N R 7 E
 S W
 5 miles N of Leland
 (distance) (direction) (nearest town)


CODED

WELL PURPOSE:

(home, irrigation, municipal, industrial)

WELL COMPLETION DATA:

- (1) diameter (inches) 12"
- (2) total depth (feet) 95'
- (3) static water level (feet) _____ below above top of ground.
- (4) casing steel 55'
 (material) (depth)
12" If telescope see back.
 (size)
- (5) screen 40' 55'
 (length) (depth to top)
12" steel
 (size) (material)
- (6) pump 40 7000
 (HP) (yield gpm)
Dsl
 (type power)
- (7) electric log no
 (yes or no)
- (organization running log)
- (8) how well bottom plugged steel plate

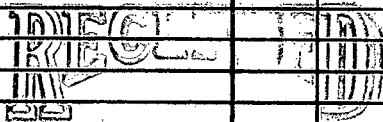


AUG 26 1986

Department of Natural Resources
 Bureau of Land & Water Resources

DRILLERS REMARKS:

If well telescopes please sketch and show depths.

GROUND LEVEL

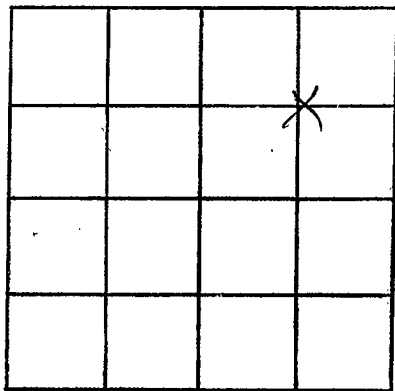

SECTION _____

Please indicate well location X.

ADDITIONAL INFORMATION

If more than one screen, show locations of each on sketch.