

MISSISSIPPI DEPARTMENT OF NATURAL RESOURCES

Bureau of Land and Water Resources

Southport Mall

P.O. Box 10631

Jackson, Mississippi 39209

WATER WELL DRILLERS LOG

CODED

WASHINGTON
B 47
MS-GW 2782

3-7-86
date well completed

19 *Ray's Pump & Well Drilling* WASHINGTON
firm name county well located

LANDOWNER: Percy BARNET
100 Peninsula Dr.
Leland, Miss
1st WELL (mailing address) 38756
WELL LOCATION:
sec. 24 T. 19 N. 7 E
S W
5 miles N of Leland
(distance) (direction) (nearest town)

description of formations encountered	from to	
CLAY	0	35
FINE SAND	35	45
COARSE SAND / pea gravel	45	100

WELL PURPOSE:
(home, irrigation, municipal, industrial)

WELL COMPLETION DATA:

- (1) diameter (inches) 12"
- (2) total depth (feet) 100'
- (3) static water level (feet) _____ below above top of ground.
- (4) casing steel 60'
(material) (depth)
12" if telescope see back.
(size)
- (5) screen 40' 60'
(length) (depth to top)
12" steel
(size) (material)
- (6) pump 40 2000
(HP) (yield gpm)
Dsl
(type power)
- (7) electric log no
(yes or no)

(organization running log) _____
(8) how well bottom plugged STEEL PLATE

CODED


RECEIVED
AUG 26 1986

Department of Natural Resources
Bureau of Land & Water Resources

DRILLERS REMARKS:

If well telescopes please sketch and show depths.

GROUND LEVEL

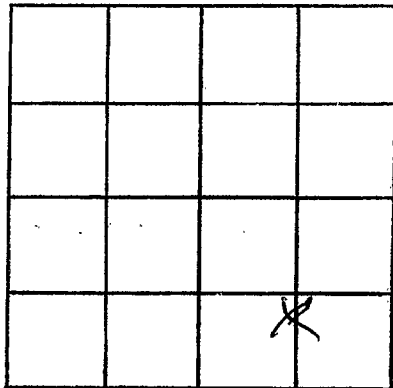

SECTION _____

Please indicate well location X.

ADDITIONAL INFORMATION

If more than one screen, show locations of each on sketch.